

ISSUED  
12.23.13 AS-BUILT

**MELTZER PROPERTIES**

**FRANCO BUILDING**  
3015 Peachtree Road NE  
Atlanta, GA 30305

Project Number:


PRELIMINARY NOT FOR CONSTRUCTION

**CONTRACTOR**

**STRUCTURAL**

**M.E.P. & F.P.**

**CIVIL**

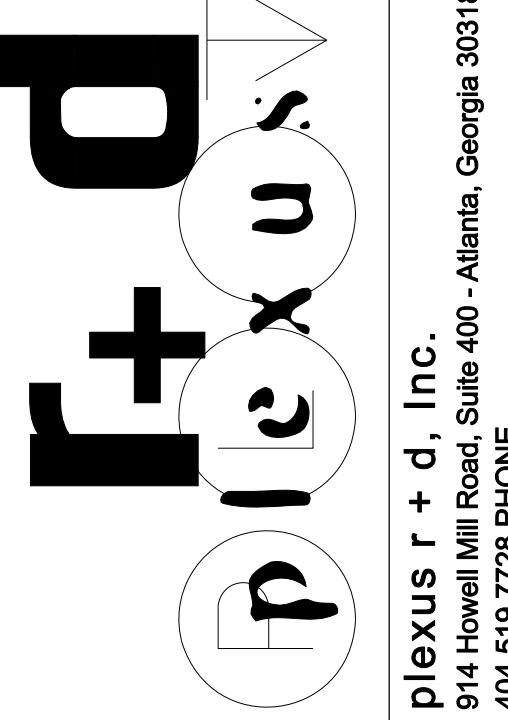

A1.07  
BUILDING SECTION  
3/16" = 1'-0"

plexus r + d, Inc.  
914 Howell Mill Road, Suite 400 - Atlanta, Georgia 30318  
404.519.7228 PHONE

© COPYRIGHT 2013 - PLEXUS R + D, INC.

