

SAP FILE NUMBER:
SAP-21-095

ZONING CLASSIFICATION:
SPI-9 SUBAREA 4
APPROVED ZONING CASE Z-21-07

ADJACENT STREETS:
PIEDMONT ROAD (TYPE 2) (GDOT STATE ROUTE 237)

SITE PLAN LEGEND:

- PROPERTY LINE
- [Pattern] STEETScape INSTALLED BY GDOT AS PART OF PIEDMONT ROAD WIDENING PROJECT (OUTSIDE THE SCOPE OF THE IMPROVEMENTS)
- [Pattern] PROPOSED HARDScape/PLAZA INCLUDED IN SCOPE OF PROJECT
- (Circle) PROPOSED TREE
- (Circle) EXISTING TREE

SAP SITE NOTES:

- ADDRESS NUMBERS ARE TO BE PROVIDED ON BUILDING AND BE A MINIMUM OF 6 INCHES IN HEIGHT.
- ALL LIGHTING THAT UP-LIGHTS TREES, BUILDINGS, OR OTHER ELEMENTS, SHALL BE LOCATED AT A MINIMUM HEIGHT OF 8 FT ABOVE THE SIDEWALK, DRIVEWAY, OR PEDESTRIAN AREA WHEN NOT LOCATED WITHIN COMPLETED LANDSCAPED AREAS.
- PER ORDINANCE 21-0-0117, ALL EXTERIOR LIGHTING ELEMENTS ALONG THE WESTERN AND NORTHERN PROPERTY BOUNDARIES SHALL BE LIGHTED ONLY WITH "FULL CUTOFF" TYPE LIGHT FIXTURES TO REDUCE LIGHT POLLUTION TO ADJOINING RESIDENTIAL PROPERTIES TO ZERO SPILLOVER AT THE PROPERTY LINE.

DEVELOPMENT SUMMARY:

SITE SUMMARY:
NET LOT AREA: 10.89 ACRES
474,206 SF

EXISTING GROCERY SQUARE FOOTAGE TO BE REMOVED: 55,187 SF

EXISTING BUILDING SQUARE FOOTAGE TO REMAIN: 97,052 SF
PROPOSED BUILDING SQUARE FOOTAGE: 54,965 SF
TOTAL BUILDING SQUARE FOOTAGE: 152,017 SF
TOTAL FLOOR AREA RATIO (FAR): 0.32

TRANSITIONAL YARD (REAR YARD): 35 FT

USEABLE OPEN SPACE:
USEABLE OPEN SPACE REQUIRED (UOSR): 47,421 SF
50% OF UOSR QUALIFYING AS PUBLIC SPACE: 23,711 SF

PROVIDED USEABLE OPEN SPACE: 48,000 SF
UOSR QUALIFYING AS PUBLIC SPACE: 24,054 SF

PARKING SUMMARY:
VEHICLE PARKING:
EXISTING: 522 SPACES
MINIMUM REQUIRED: 75 SPACES
MAXIMUM ALLOWED: 522 SPACES*
PROPOSED PARKING AFTER RESTRIPING: 498 SPACES

*PER APPROVED ZONING ORDINANCE (Z-21-07), PROPOSED PARKING COUNT WILL NOT EXCEED EXISTING PARKING COUNT.

BICYCLE PARKING:
MINIMUM REQUIRED: 38 SPACES
PROPOSED: 38 SPACES

LOADING DOCK REQUIRED: 1 - 12' X 35' SPACE
LOADING DOCK PROVIDED: 1 - 12' X 35' SPACE

APPROVED: SPECIAL ADMINISTRATIVE PERMIT

with Red-Lines with Conditions Revision

DATE: 09/03/2021 REVIEWER: Alex Deus

APPLICATION NUMBER: SAP-21-095

GEORGIA811
Utility Protection Center, Inc.
Know what's below. Call before you dig.

GRAPHIC SCALE IN FEET
0 20 40 80

Kimley-Horn
© 2011 KIMLEY-HORN AND ASSOCIATES, INC.
817 W. PEACHTREE STREET, NW
THE BILTMORE, SUITE 601
ATLANTA, GEORGIA 30308
PHONE: (404) 416-8700
WWW.KIMLEY-HORN.COM

REGENCY CENTERS
3715 NORTHSIDE PARKWAY NW
BUILDING 400, SUITE 400
ATLANTA, GA 30327
PHONE: 404-575-5200

NO.	SAP COMMENT RESPONSE	DATE	ZLR	BY
1	SAP SUBMITTAL	07/02/2021		
2	SAP COMMENT RESPONSE	08/13/2021		

ISSUANCE AND REVISION DESCRIPTIONS

NO.	ISSUANCE AND REVISION DESCRIPTIONS	DATE	ZLR	BY
1				


PROJECT
PIEDMONT PEACHTREE CROSSING
3330 PIEDMONT ROAD NE, ATLANTA, GA 30305
LAND LOT 61 & 62, 17TH DISTRICT

GEORGIA REGISTERED PROFESSIONAL SURVEYOR
No. PE043951
ALEX DEUS
08/13/21


GSWCC NO. (LEVEL II) 0000076496
DRAWN BY: JRN
DESIGNED BY: ZLR
REVIEWED BY: EFM
DATE: 07/02/2021
PROJECT NO.: 012733046
TITLE: SAP SITE PLAN
SHEET NUMBER: C0-30

SAP-21-095
 OFFICE OF ZONING & DEVELOPMENT
RECEIVED
 DATE: 7/2/2021

HA
 Hiscutt Associates
 ARCHITECTURE
 3625 Brookside Parkway
 Suite 395
 Alpharetta, Georgia 30022
 Phone: 770.753.8787
 Web: www.hiscutt-ala.com

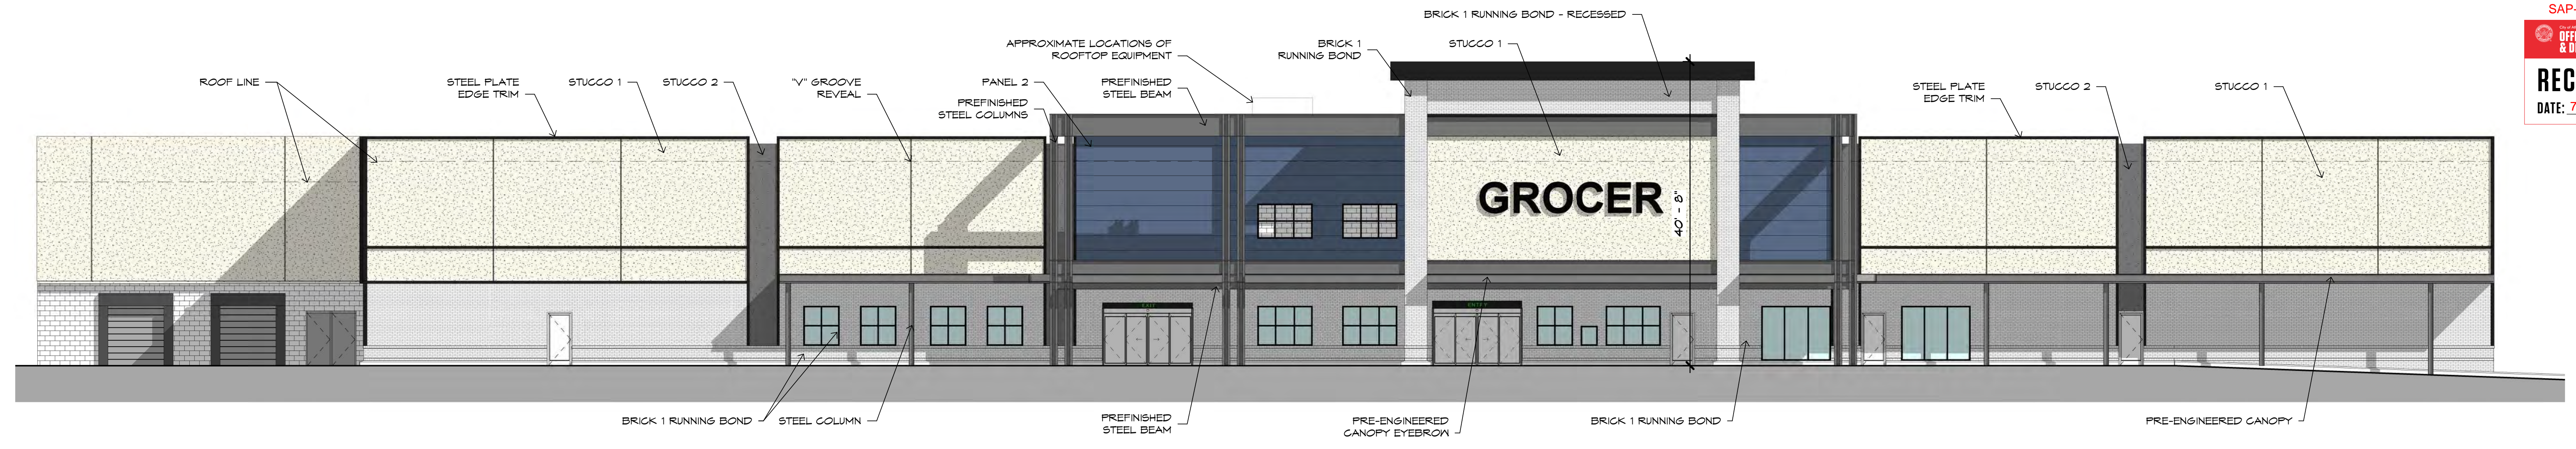


1 GROCER FRONT ELEVATION
 PR-3 SCALE 1" = 10'-0"

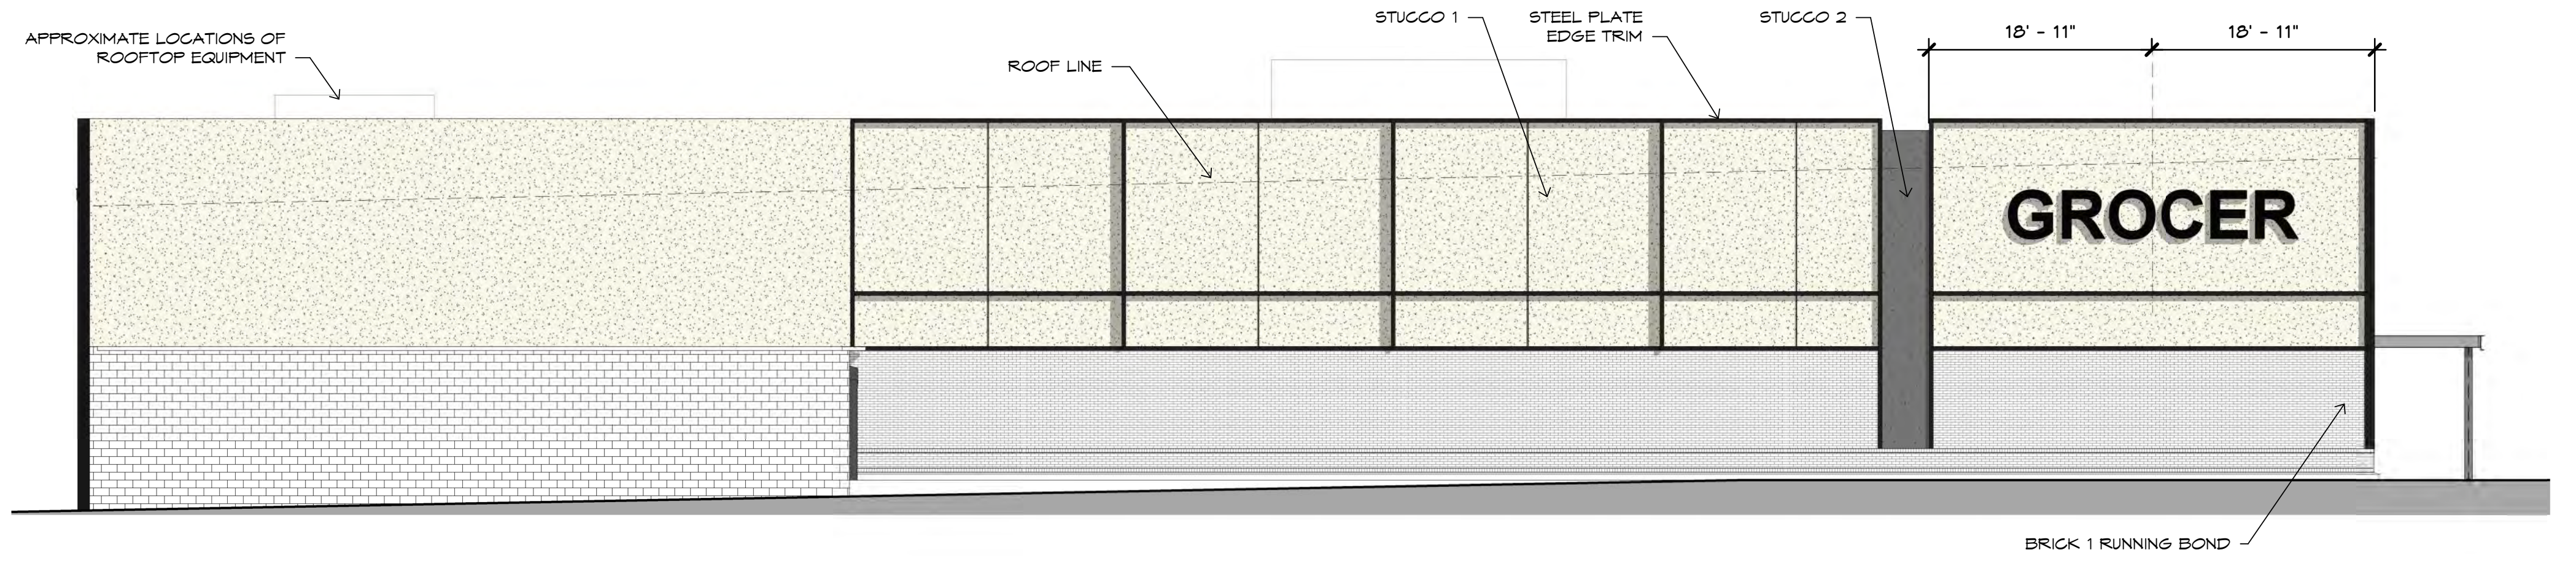


2 GROCER LEFT SIDE ELEVATION
 PR-3 SCALE 1" = 10'-0"

City of Atlanta (Department of City Planning)
OFFICE OF ZONING & DEVELOPMENT
APPROVED: SPECIAL ADMINISTRATIVE PERMIT
 with Red-Lines with Conditions Revision
 DATE: 09/02/2021 REVIEWER: Alex Deus
 APPLICATION NUMBER: SAP-21-095

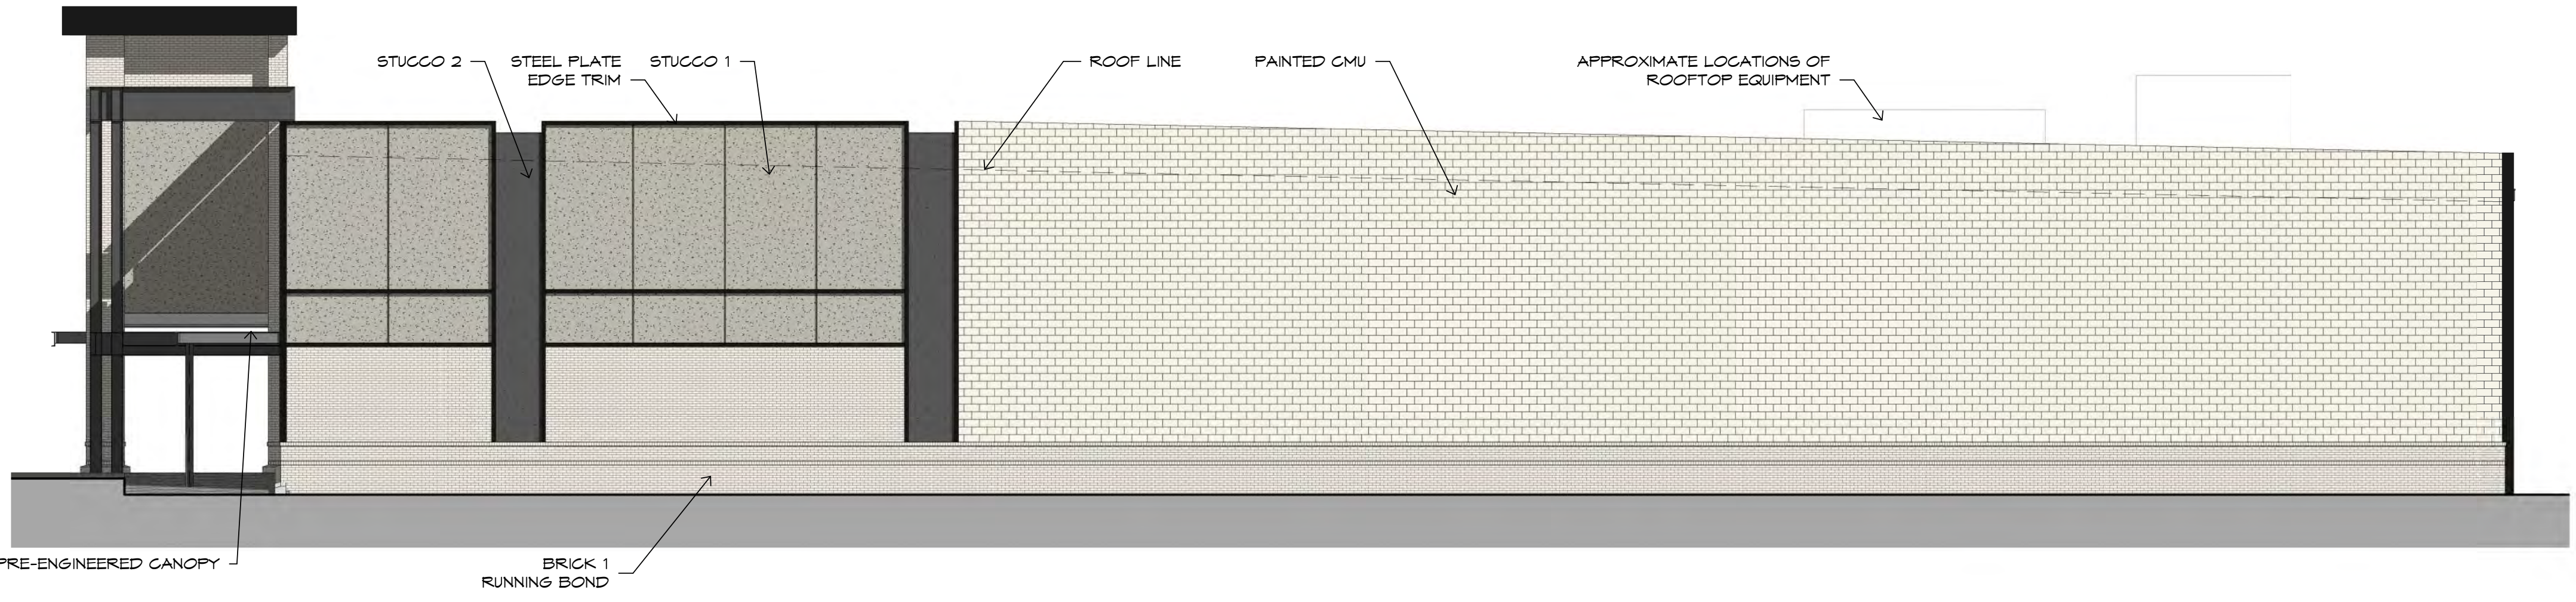

3 GROCER RIGHT SIDE ELEVATION
 PR-3 SCALE 1" = 10'-0"

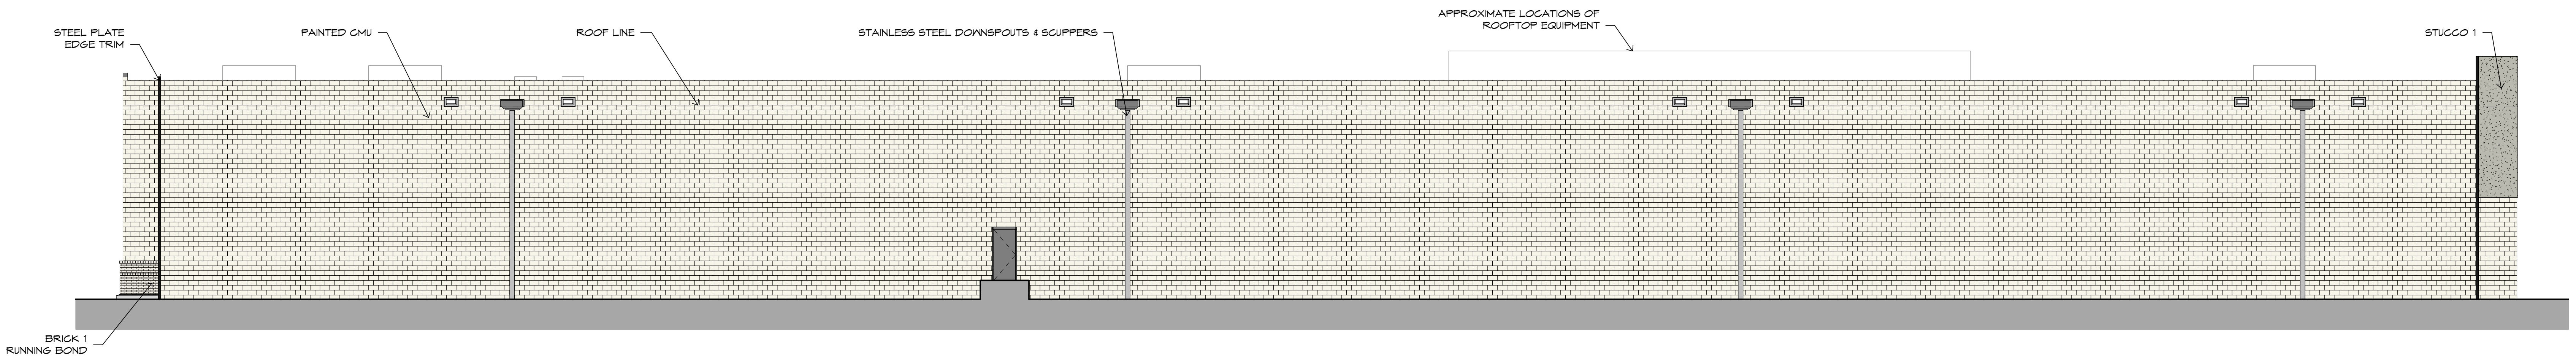

4 GROCER REAR ELEVATION
 PR-3 SCALE 1" = 10'-0"

06/22/21
 THESE DOCUMENTS ARE PRELIMINARY. HIS CUTT ASSOCIATES, INC. ASSUMES NO LIABILITY FOR THE USE OF THESE DOCUMENTS FOR ANY PROJECT OTHER THAN THAT AUTHORIZED BY HIS CUTT ASSOCIATES, INC. COPYRIGHT © 2021 HIS CUTT ASSOCIATES, INC.

PROJECT: **PIEDMONT PEACHTREE CROSSING**
 3330 PIEDMONT ROAD NE
 ATLANTA, GEORGIA
 FOR: ATLANTA, GEORGIA 30305

SHEET TITLE:
GROCER ELEVATIONS

ISSUE DATE: 6/30/21
 FILE: 17-132
 DRAWN BY: SML
 PROJECT NO: 17-132

PR-3

NORTH RETAIL ELEVATION - PART 1



City of Atlanta | Department of City Planning
OFFICE OF ZONING & DEVELOPMENT


APPROVED: SPECIAL ADMINISTRATIVE PERMIT

with Red-Lines with Conditions Revision


09/02/2021 Alex Deus
DATE REVIEWER

SAP-21-095
APPLICATION NUMBER

SIGNAGE FOR REFERENCE ONLY

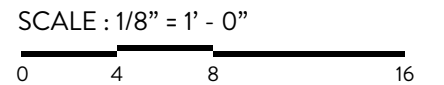

NORTH RETAIL ELEVATION - PART 2

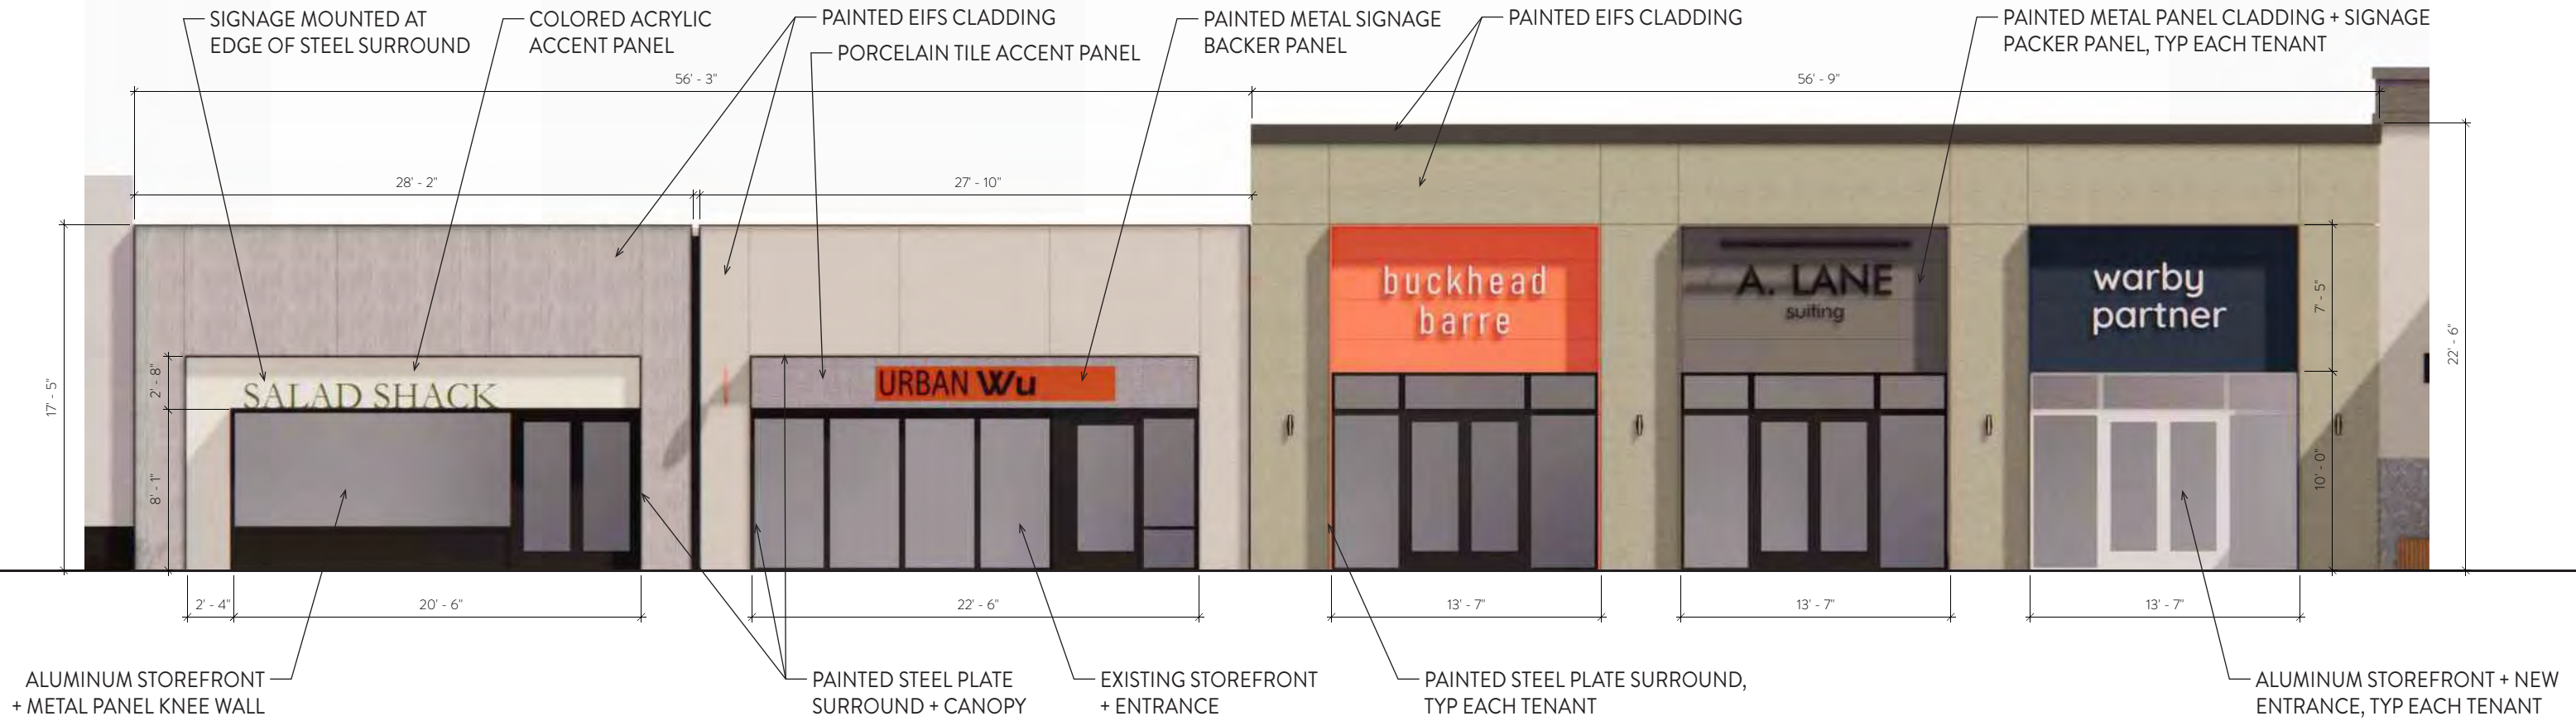

City of Atlanta | Department of City Planning
OFFICE OF ZONING & DEVELOPMENT


APPROVED: SPECIAL ADMINISTRATIVE PERMIT

with Red-Lines with Conditions Revision
 Alex Deus

DATE: 09/02/2021 REVIEWER: _____
 SAP-21-095

APPLICATION NUMBER: _____

SIGNAGE FOR REFERENCE ONLY

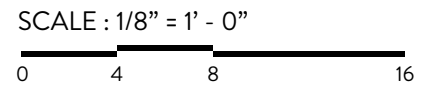

NORTH RETAIL ELEVATION - PART 3



City of Atlanta | Department of City Planning
OFFICE OF ZONING & DEVELOPMENT

APPROVED: SPECIAL ADMINISTRATIVE PERMIT

with Red Lines with Conditions Revision


09/02/2021
 Alex Deus

DATE: _____ REVIEWER: _____
 SAP-21-095

APPLICATION NUMBER

SIGNAGE FOR REFERENCE ONLY

SCALE : 1/8" = 1' - 0"

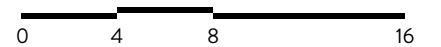

NORTH RETAIL ELEVATION - PIEDMONT ENDCAP (PART 4)



City of Atlanta | Department of City Planning
OFFICE OF ZONING & DEVELOPMENT


APPROVED: SPECIAL ADMINISTRATIVE PERMIT

with Red-Lines with Conditions Revision
 09/02/2021 Alex Deus

DATE: _____ REVIEWER: _____
 SAP-21-095

APPLICATION NUMBER: _____

SIGNAGE FOR REFERENCE ONLY

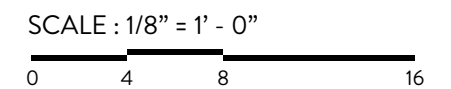

EAST (PIEDMONT) ELEVATION - NORTH ENDCAP




City of Atlanta | Department of City Planning
OFFICE OF ZONING & DEVELOPMENT

APPROVED: SPECIAL ADMINISTRATIVE PERMIT


with Red-Lines with Conditions Revision
 09/02/2021 Alex Deus

DATE _____ REVIEWER _____

 APPLICATION NUMBER SAP-21-095

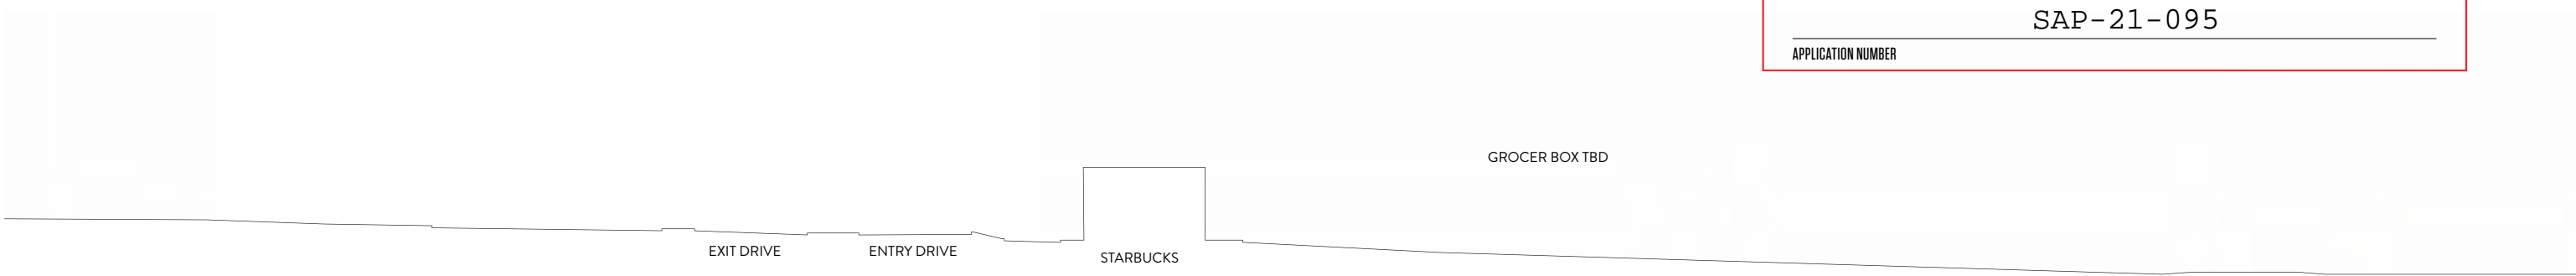

SIGNAGE FOR REFERENCE ONLY

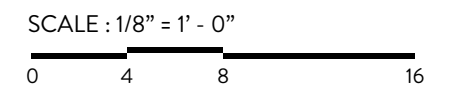

EAST (PIEDMONT) ELEVATION - JUNIOR BOX



City of Atlanta | Department of City Planning
OFFICE OF ZONING & DEVELOPMENT

APPROVED: SPECIAL ADMINISTRATIVE PERMIT


with Red-Lines with Conditions Revision
 09/02/2021 Alex Deus

DATE _____ REVIEWER _____
 SAP-21-095

APPLICATION NUMBER _____

SIGNAGE FOR REFERENCE ONLY

SCALE : 1/8" = 1' - 0"

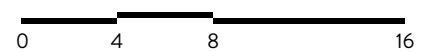

EAST (PIEDMONT) ELEVATION - SOUTH ENDCAP



City of Atlanta | Department of City Planning
OFFICE OF ZONING & DEVELOPMENT

APPROVED: SPECIAL ADMINISTRATIVE PERMIT


with Red-Lines with Conditions Revision
 09/02/2021 Alex Deus

DATE: SAP-21-095 REVIEWER:

APPLICATION NUMBER:

SIGNAGE FOR REFERENCE ONLY

SCALE: 1/8" = 1' - 0"

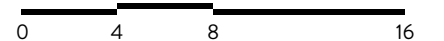

SOUTH RETAIL ELEVATION - PIEDMONT ENDCAP (PART 1)




City of Atlanta | Department of City Planning
OFFICE OF ZONING & DEVELOPMENT

APPROVED: SPECIAL ADMINISTRATIVE PERMIT


with Red-Lines with Conditions Revision
 Alex Deus

DATE: 09/02/2021 REVIEWER: _____
 APPLICATION NUMBER: SAP-21-095

SIGNAGE FOR REFERENCE ONLY

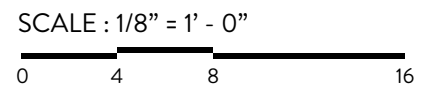

SOUTH RETAIL ELEVATION - PART 2

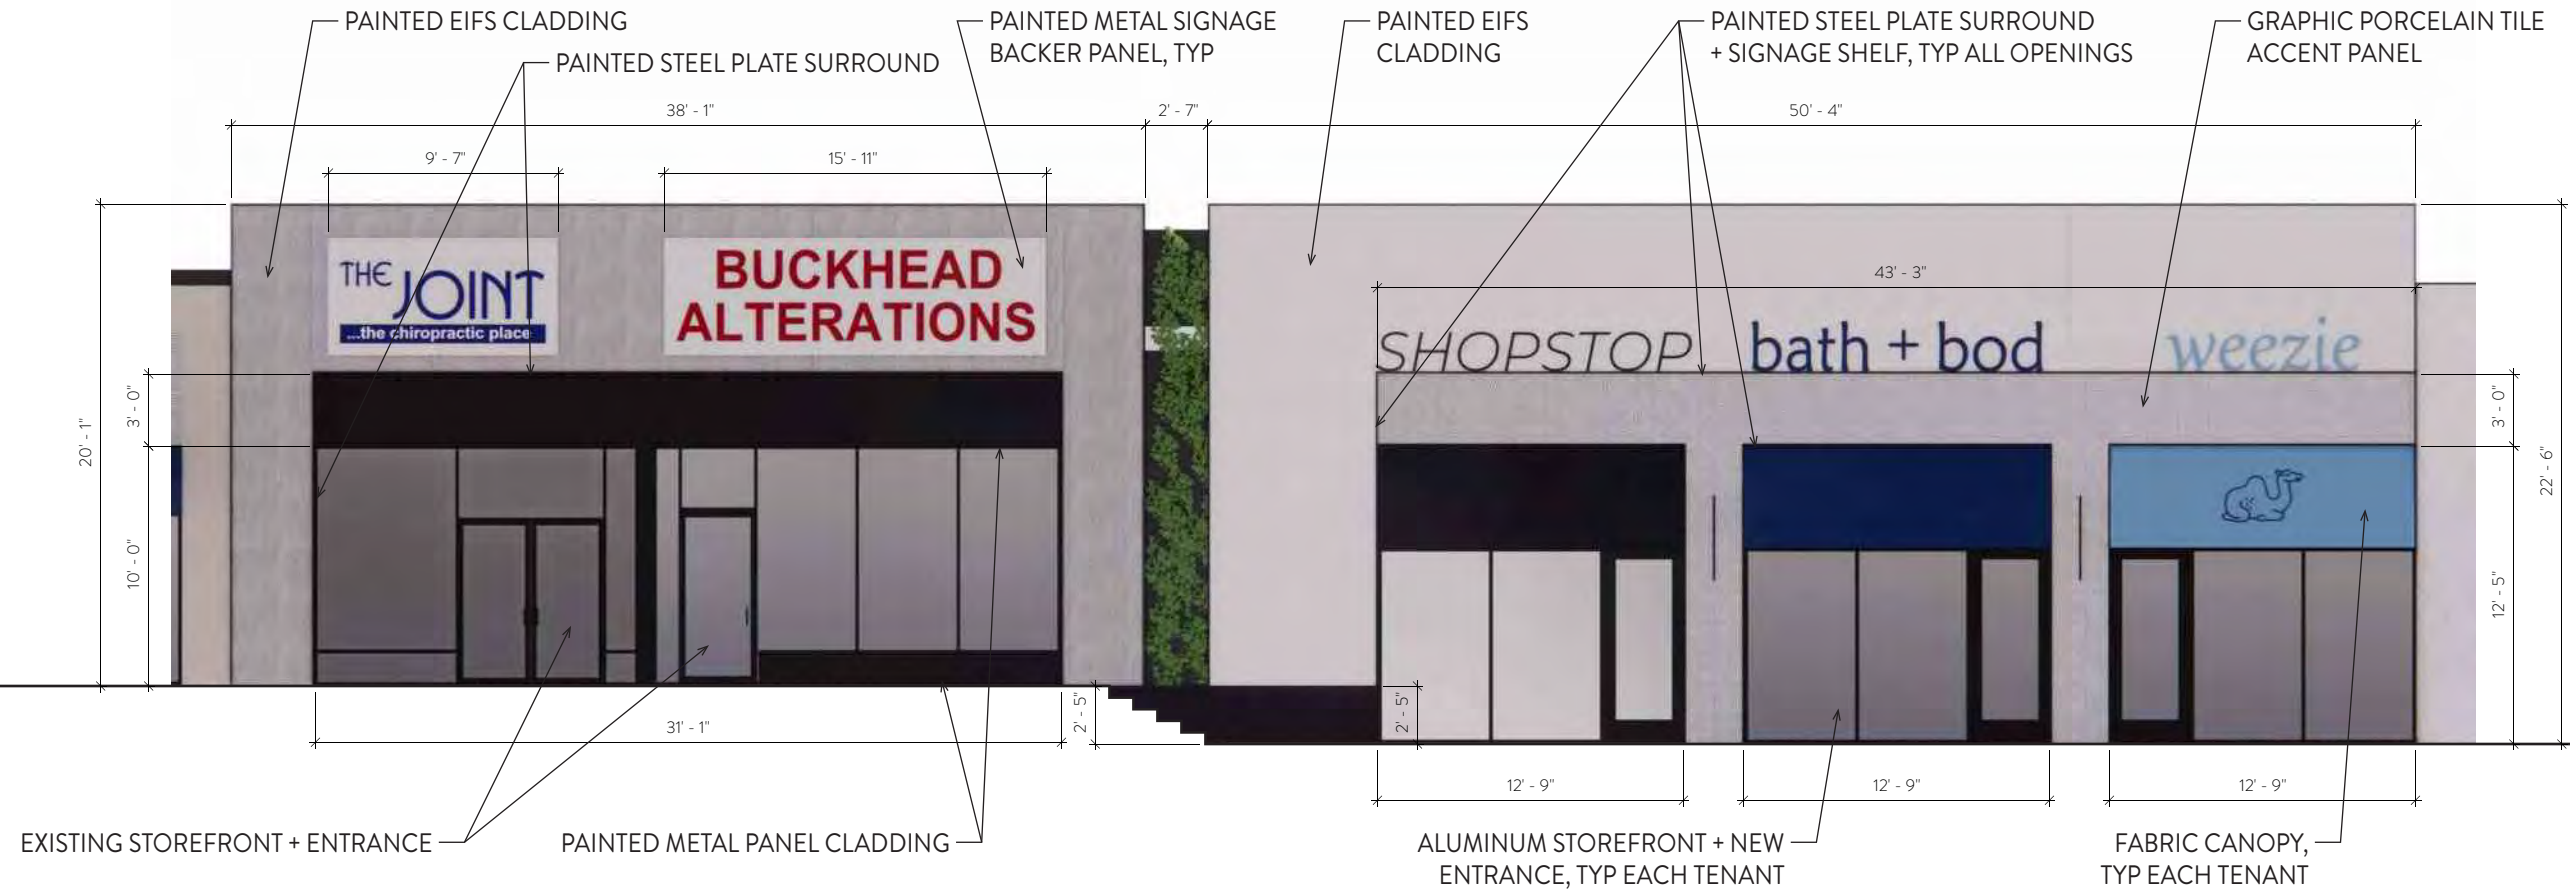

City of Atlanta | Department of City Planning
OFFICE OF ZONING & DEVELOPMENT

APPROVED: SPECIAL ADMINISTRATIVE PERMIT

with Red-Lines with Conditions Revision
 09/02/2021 Alex Deus

DATE REVIEWER
 _____ SAP-21-095

APPLICATION NUMBER

SIGNAGE FOR REFERENCE ONLY

SCALE : 1/8" = 1' - 0"
 0 4 8 16

SOUTH RETAIL ELEVATION - PART 3



City of Atlanta | Department of City Planning
OFFICE OF ZONING & DEVELOPMENT


APPROVED: SPECIAL ADMINISTRATIVE PERMIT

with Red Lines with Conditions Revision
 09/02/2021 Alex Deus


DATE: _____ REVIEWER: SAP-21-095

APPLICATION NUMBER: _____

SIGNAGE FOR REFERENCE ONLY

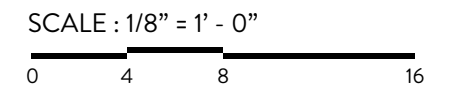

SOUTH RETAIL ELEVATION - PART 4

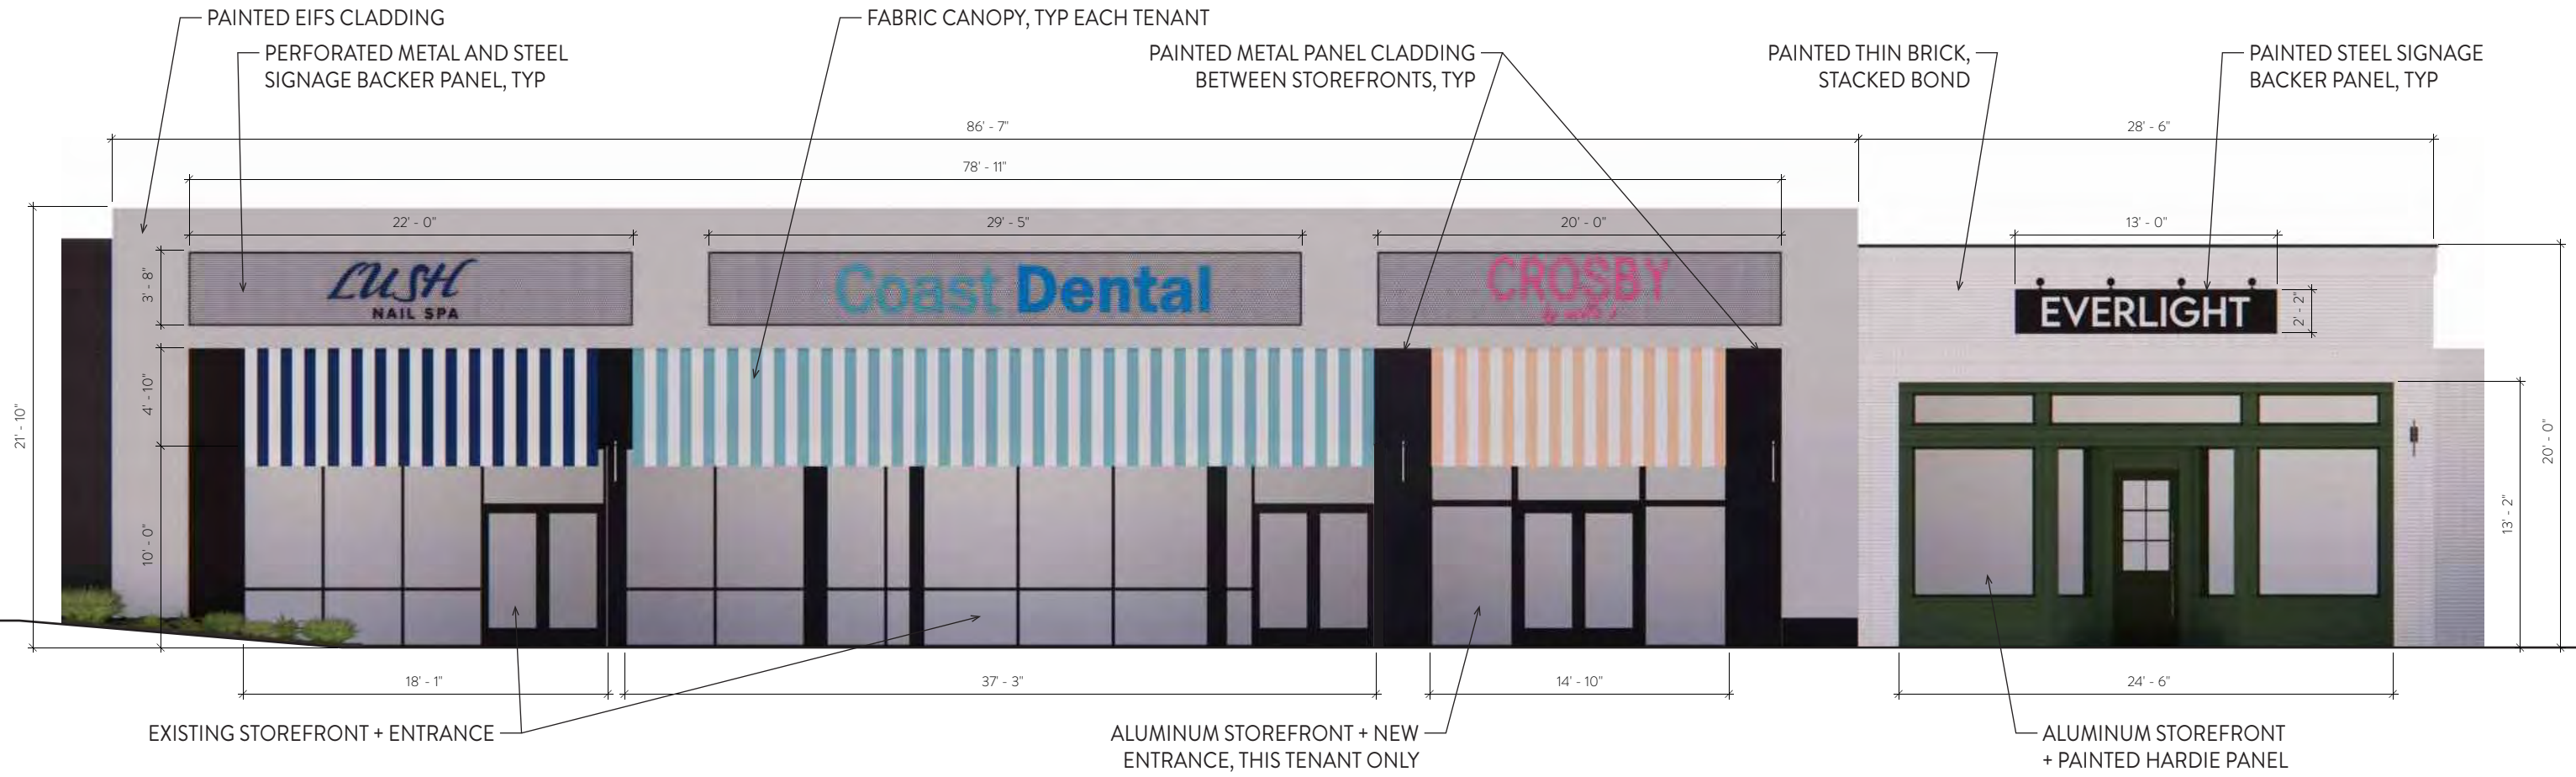

City of Atlanta | Department of City Planning
OFFICE OF ZONING & DEVELOPMENT


APPROVED: SPECIAL ADMINISTRATIVE PERMIT

with Red-Lines with Conditions Revision

DATE: 09/02/2021 REVIEWER: Alex Deus

APPLICATION NUMBER: SAP-21-095

SIGNAGE FOR REFERENCE ONLY

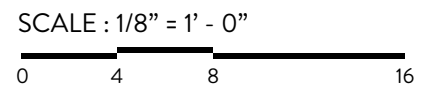

Burtons Grill & Bar – Buckhead Landing

2/27/24

Proposed Revision of Exterior Façade:

Burtons Grill & Bar, a Tenant at Buckhead Landing at 3330 Piedmont Rd NE, Atlanta, GA has leased 2 spaces (#27 & #28) within the development. To visually unite these spaces, we have proposed to replace the former 'Smoothie King façade' with finishes to match the larger space, whose façade was renovated in the recent renovation.

The scope of work is limited to 13' of the structure. We will be matching the parapet height, finishes, and colors of the new renovated facade.

Best regards,



Bill Whitlock, AIA, NCARB

Linear representation of the proposed facade material changes from EIFS to brick. Facade renovation permitted under BB-202206921

Proposed outdoor dining area on existing concrete sidewalk patio as approved in SAP-21-095

Burton's Grill and Bar. No changes to site plan are required for the revision to SAP-21-095. The building facade elevations will change slightly because of the proposed material change.


DEVELOPMENT SUMMARY:

SITE SUMMARY:
 NET LOT AREA: 10.89 ACRES / 474,206 SF
 EXISTING GROCERY SQUARE FOOTAGE TO BE REMOVED: 55,187 SF
 EXISTING BUILDING SQUARE FOOTAGE TO REMAIN: 97,052 SF
 PROPOSED BUILDING SQUARE FOOTAGE: 54,985 SF
 TOTAL BUILDING SQUARE FOOTAGE: 152,037 SF
 TOTAL FLOOR AREA RATIO (FAR): 0.32
 TRANSITIONAL YARD (REAR YARD): 35 FT
 USEABLE OPEN SPACE:
 USEABLE OPEN SPACE REQUIRED (UOSR): 47,421 SF
 50% OF UOSR QUALIFYING AS PUBLIC SPACE: 23,711 SF
 PROVIDED USEABLE OPEN SPACE: 48,000 SF
 UOSR QUALIFYING AS PUBLIC SPACE: 24,054 SF

PARKING SUMMARY:
 VEHICLE PARKING:
 EXISTING: 522 SPACES
 MINIMUM REQUIRED: 75 SPACES
 MAXIMUM ALLOWED: 522 SPACES
 PROPOSED PARKING AFTER RESTRIPING: 481 SPACES
 BICYCLE PARKING:
 MINIMUM REQUIRED: 38 SPACES
 PROVIDED: 38 SPACES
 LOADING DOCK REQUIRED: 1 - 12' X 35' SPACE
 LOADING DOCK PROVIDED: 1 - 12' X 35' SPACE

*PER APPROVED ZONING ORDINANCE (Z-21-07), PROPOSED PARKING COUNT WILL NOT EXCEED EXISTING PARKING COUNT.

- SITE NOTES:**
- THE PROPOSED BUILDING INFORMATION SHOWN HEREIN IS FROM AN ELECTRONIC FILE PROVIDED BY ASD | SKY, DATED 05/16/2022 AND IS FOR ILLUSTRATIVE PURPOSES ONLY. CONTRACTOR SHALL REFERENCE ARCHITECTURAL PLANS FOR EXACT BUILDING INFORMATION.
 - EXISTING CONDITIONS SHOWN HEREON ARE FROM A SURVEY FILE PROVIDED BY LEICRAW ENGINEERING INC., DATED 03/7/2018.
 - ALL DIMENSIONS ARE FROM FACE OF CURB TO FACE OF CURB UNLESS OTHERWISE NOTED.
 - SIDEWALK INSTALLED AGAINST BACK OF CURB SHALL BE INSTALLED PER THE PLAN AS MEASURED FROM THE BACK OF CURB.
 - ALL SIGNAGE AND STRIPING MUST MEET THE LATEST REQUIREMENTS SET FORTH BY MUTCD, GDOT, AND GEORGIA STATE CODE. ALL PAVEMENT MARKINGS TO BE INSTALLED WITH SLIP RESISTANT PAINT.
 - REFERENCE LANDSCAPE PLANS FOR ALL HARDSCAPE AND LANDSCAPE DETAILS AND SPECIFICATIONS.
 - ALL PAVEMENT MARKINGS TO BE INSTALLED WITH SLIP RESISTANT PAINT.

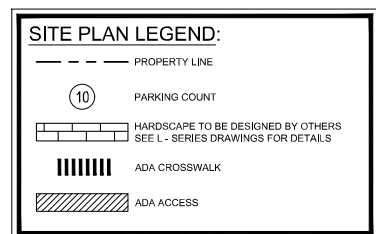

- GENERATOR NOTES:**
- PROPOSED LOCATION OF STORAGE TANK(S) AT THE SUBJECT SITE IS:
 - NOT WITHIN 500 FEET OF ANY EXISTING COMMUNITY WATER SUPPLY WELL
 - NOT WITHIN 500 FEET OF ANY NON-TRANSIENT, NON-COMMUNITY WATER SUPPLY WELL
 - NOT WITHIN 100 FEET OF ANY OTHER EXISTING POTABLE WATER SUPPLY WELL

Kimley»Horn
 1200 PEACHTREE STREET NE
 ATLANTA, GEORGIA 30309
 PHONE 404.419.8700
 WWW.KIMLEYHORN.COM

REGENCY CENTERS
 3715 NORTHSIDE PARKWAY NW #400
 ATLANTA, GA 30305
 PHONE 404.575.3200

NO.	REVISION DESCRIPTIONS	DATE	BY
00000001	DATE		
00000002	DATE		
00000003	DATE		
00000004	DATE		
00000005	DATE		
00000006	DATE		
00000007	DATE		
00000008	DATE		
00000009	DATE		
00000010	DATE		


BUCKHEAD LANDING
 3300 MARKET AVENUE, ATLANTA, GA 30305
 LAND LOTS 61 & 62, 17TH DISTRICT

GEORGIA REGISTERED PROFESSIONAL ENGINEER
 05/09/23

GEWCC CERT. LEVEL: 0000076496
 DRAWN BY: DLP
 DESIGNED BY: DLP
 REVIEWED BY: ZLR
 DATE: 07/08/2022
 PROJECT NO: 012733046
 TITLE: SITE PLAN

C2-00

ISSUED FOR CONSTRUCTION

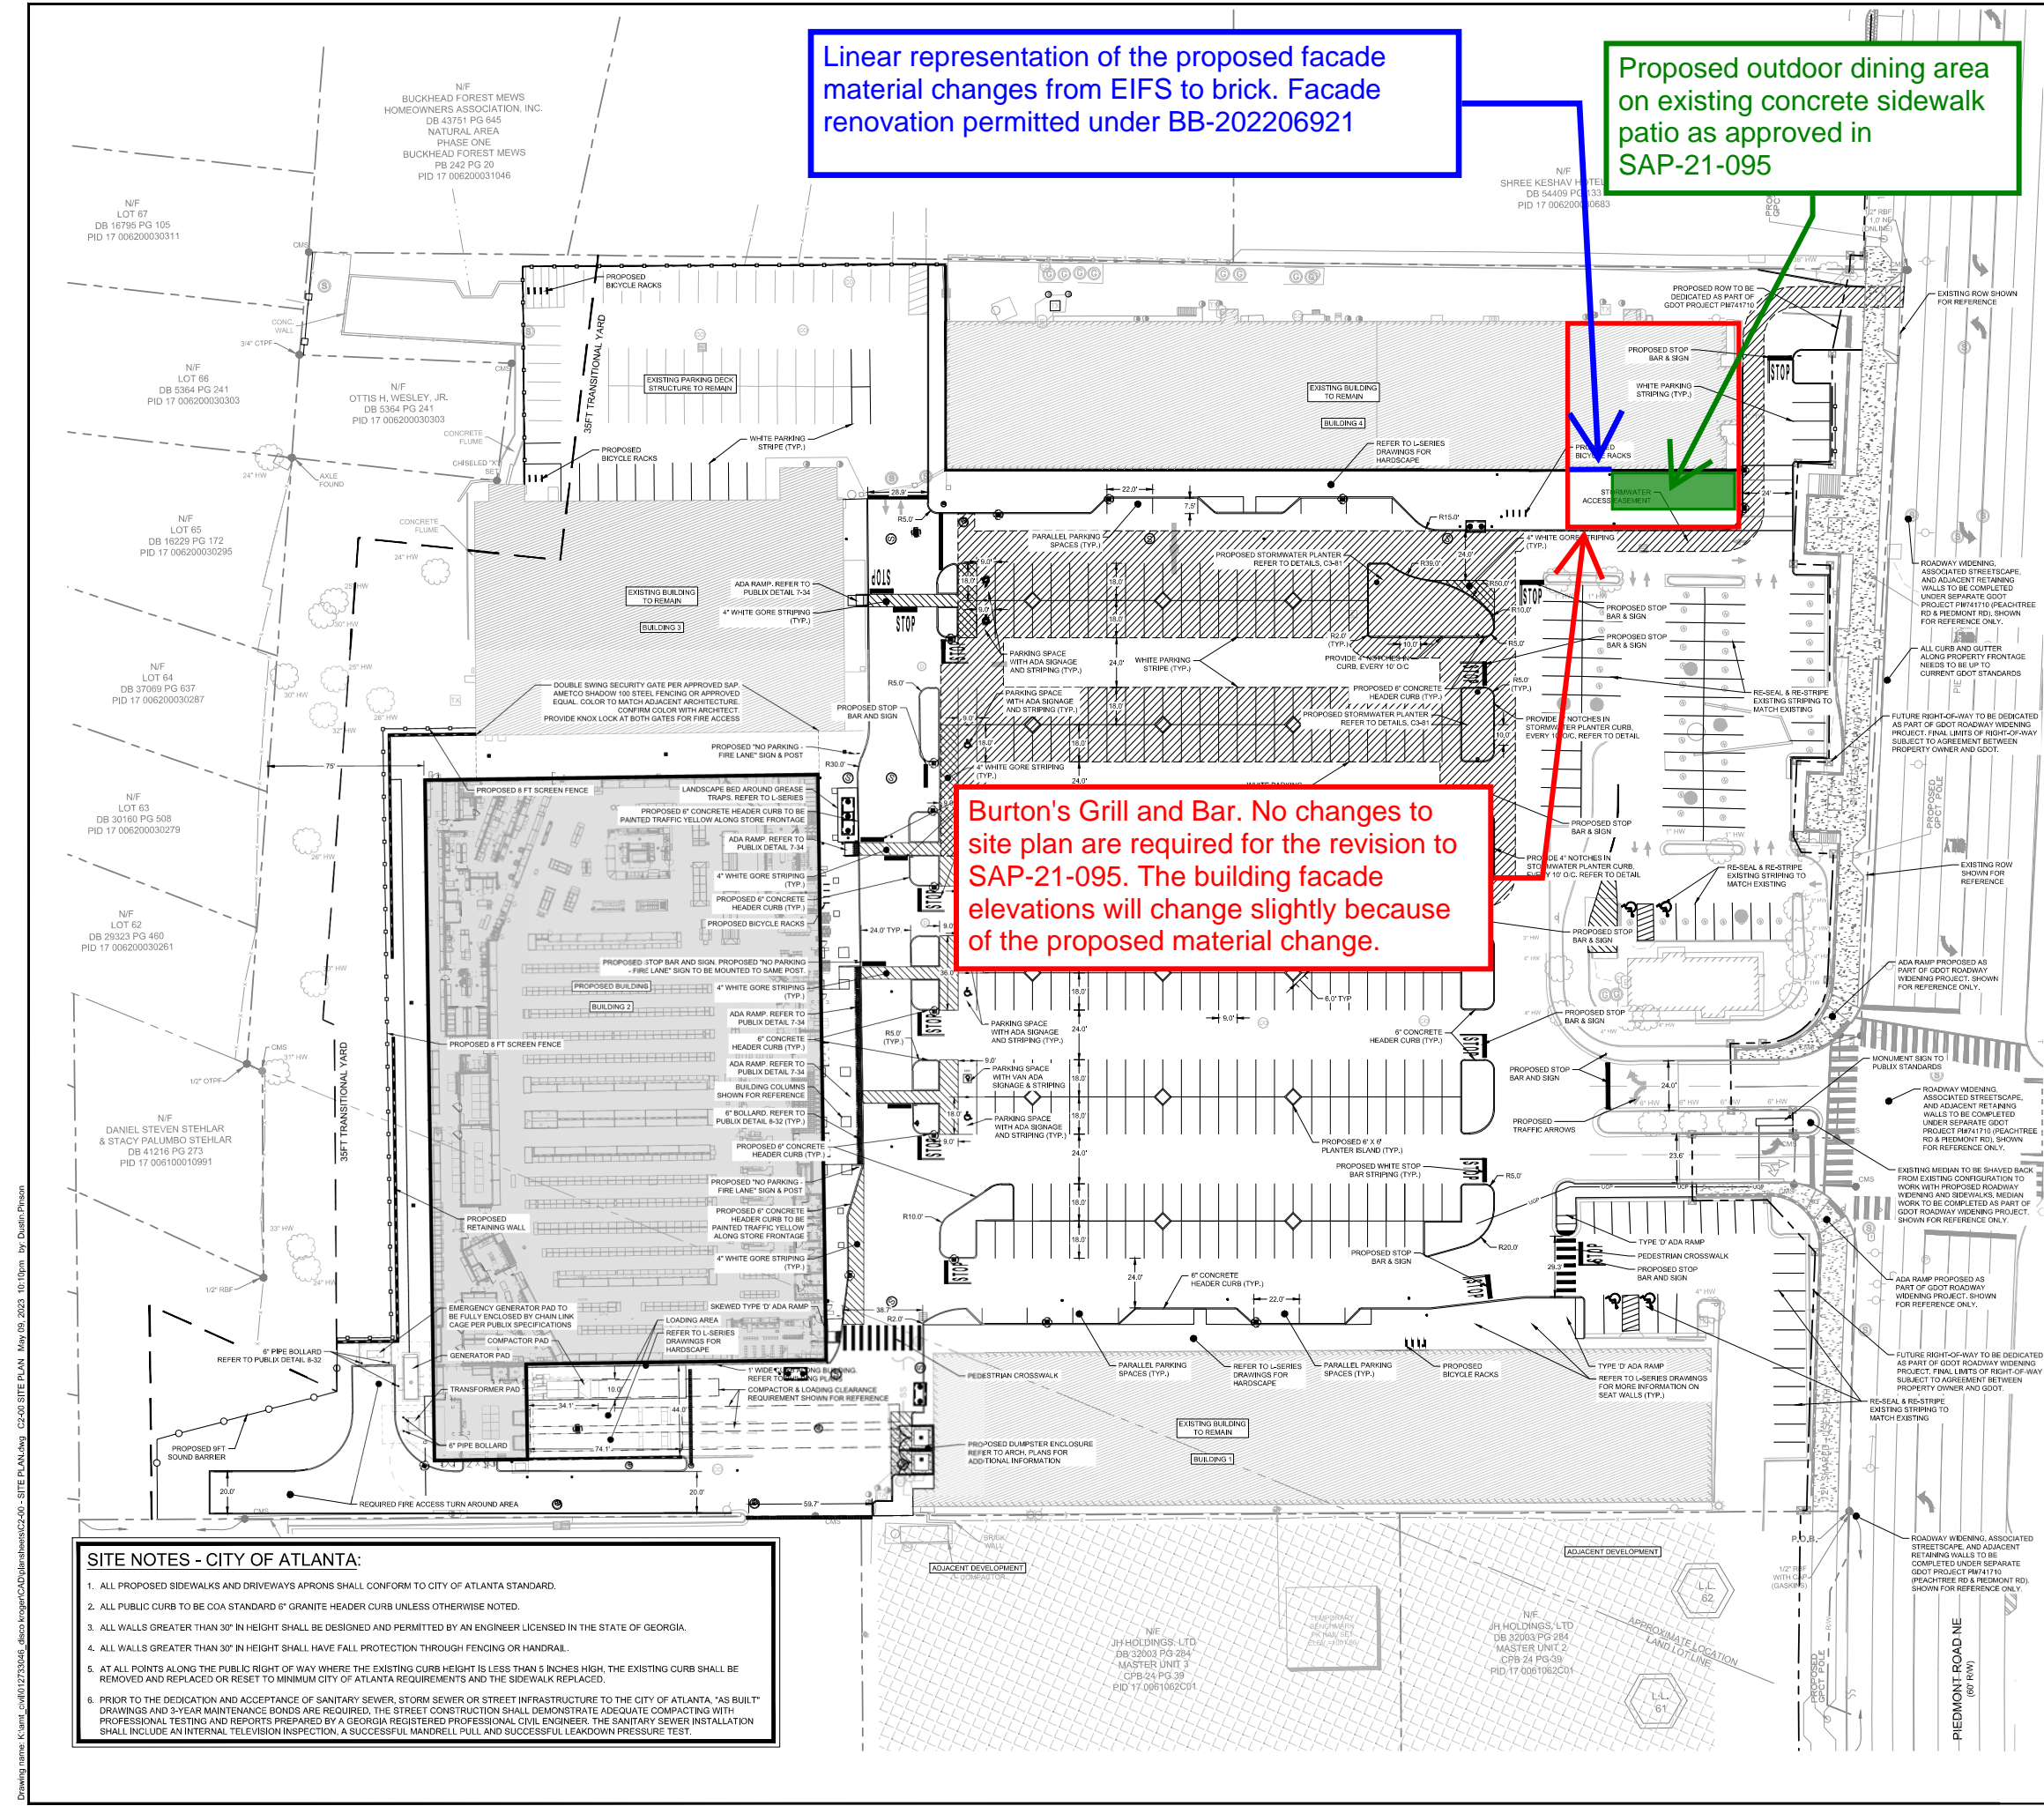

- SITE NOTES - CITY OF ATLANTA:**
- ALL PROPOSED SIDEWALKS AND DRIVEWAYS APRONS SHALL CONFORM TO CITY OF ATLANTA STANDARD.
 - ALL PUBLIC CURB TO BE COA STANDARD 6" GRANITE HEADER CURB UNLESS OTHERWISE NOTED.
 - ALL WALLS GREATER THAN 30" IN HEIGHT SHALL BE DESIGNED AND PERMITTED BY AN ENGINEER LICENSED IN THE STATE OF GEORGIA.
 - ALL WALLS GREATER THAN 30" IN HEIGHT SHALL HAVE FALL PROTECTION THROUGH FENCING OR HANDRAIL.
 - AT ALL POINTS ALONG THE PUBLIC RIGHT OF WAY WHERE THE EXISTING CURB HEIGHT IS LESS THAN 5 INCHES HIGH, THE EXISTING CURB SHALL BE REMOVED AND REPLACED OR RESET TO MINIMUM CITY OF ATLANTA REQUIREMENTS AND THE SIDEWALK REPLACED.
 - PRIOR TO THE DEDICATION AND ACCEPTANCE OF SANITARY SEWER, STORM SEWER OR STREET INFRASTRUCTURE TO THE CITY OF ATLANTA, "AS BUILT" DRAWINGS AND 3-YEAR MAINTENANCE BONDS ARE REQUIRED. THE STREET CONSTRUCTION SHALL DEMONSTRATE ADEQUATE COMPACTING WITH PROFESSIONAL TESTING AND REPORTS PREPARED BY A GEORGIA REGISTERED PROFESSIONAL CIVIL ENGINEER. THE SANITARY SEWER INSTALLATION SHALL INCLUDE AN INTERNAL TELEVISION INSPECTION, A SUCCESSFUL MANDRELL PULL AND SUCCESSFUL LEAKDOWN PRESSURE TEST.

Drawing name: K:\amc_civil\012733046_disco\kroger\CAD\plan\sheet\C2-00_SITE PLAN.dwg, C2-00_SITE PLAN, May 09, 2023, 10:10am, by: Dustin Phipps



NORTH RETAIL ELEVATION - PART 3



City of Atlanta | Department of City Planning
OFFICE OF ZONING & DEVELOPMENT

APPROVED: SPECIAL ADMINISTRATIVE PERMIT


with Red Lines with Conditions Revision


09/02/2021
 Alex Deus

DATE: _____ REVIEWER: _____
 SAP-21-095

APPLICATION NUMBER


SIGNAGE FOR REFERENCE ONLY

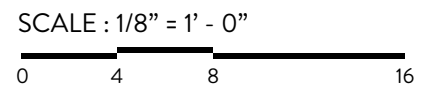

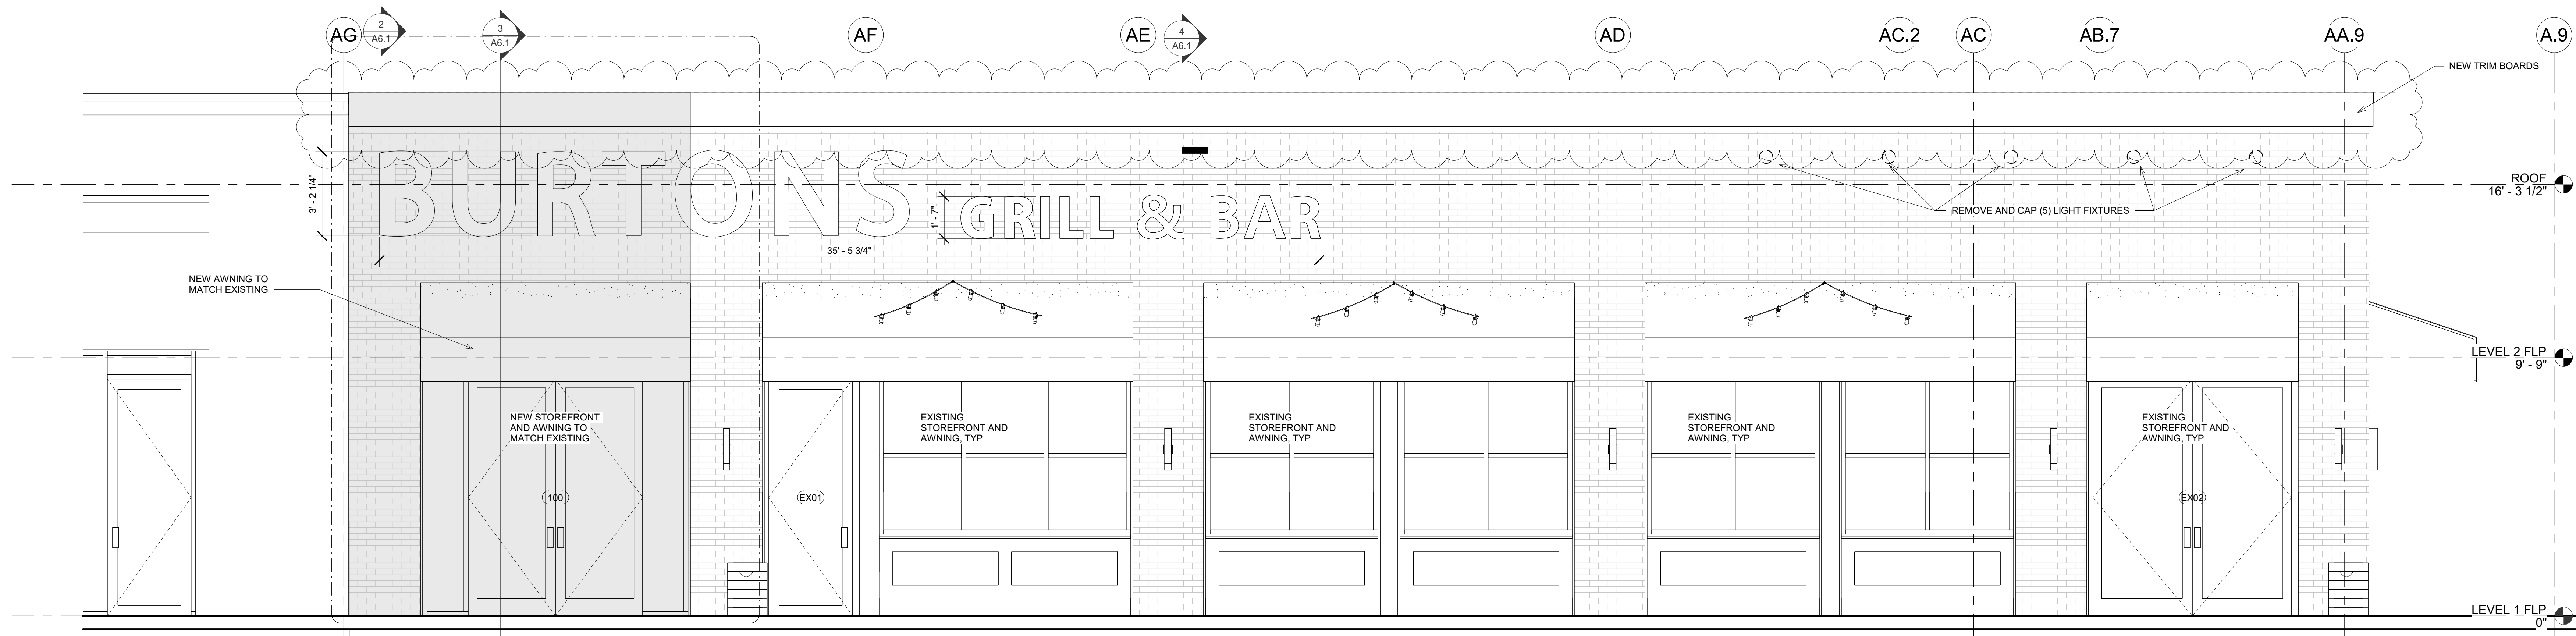


1 Elevation 2 - a
3/8" = 1'-0"

NOTE:
EXTERIOR WORK UNDER
SEPARATE CONTRACT

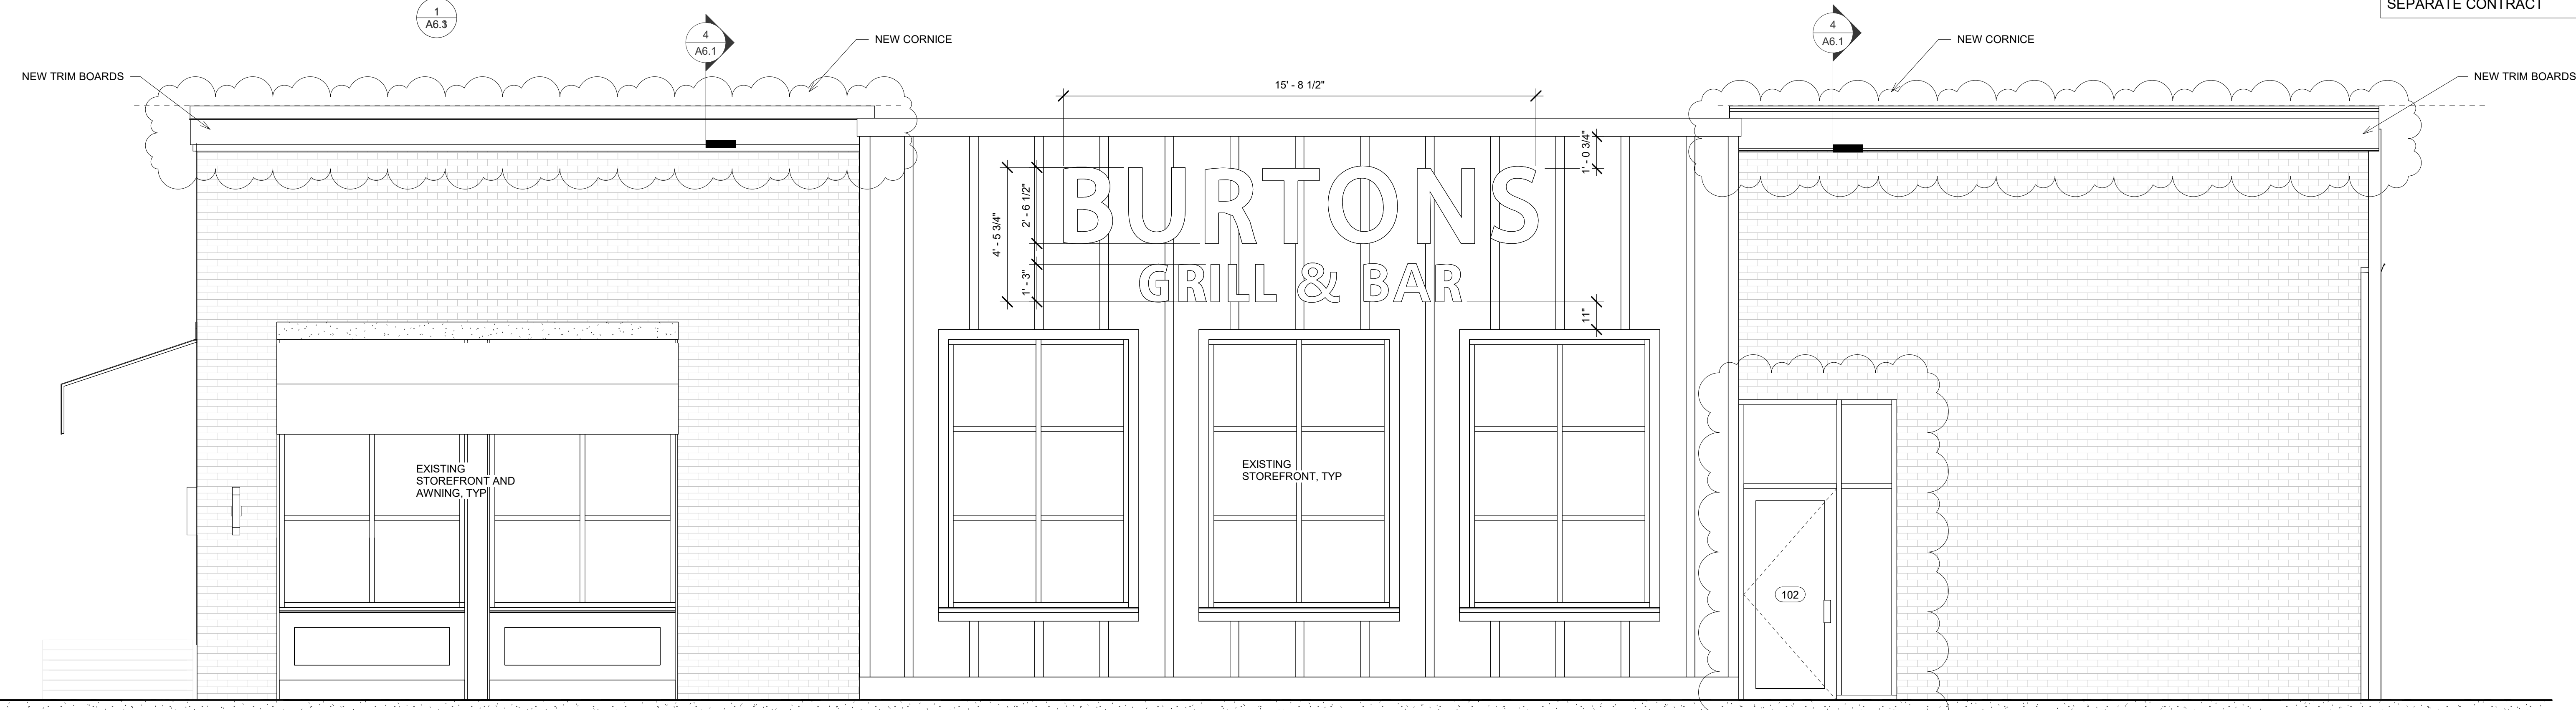

2 Elevation 3 - a
3/8" = 1'-0"

NOTE:
EXTERIOR WORK UNDER
SEPARATE CONTRACT

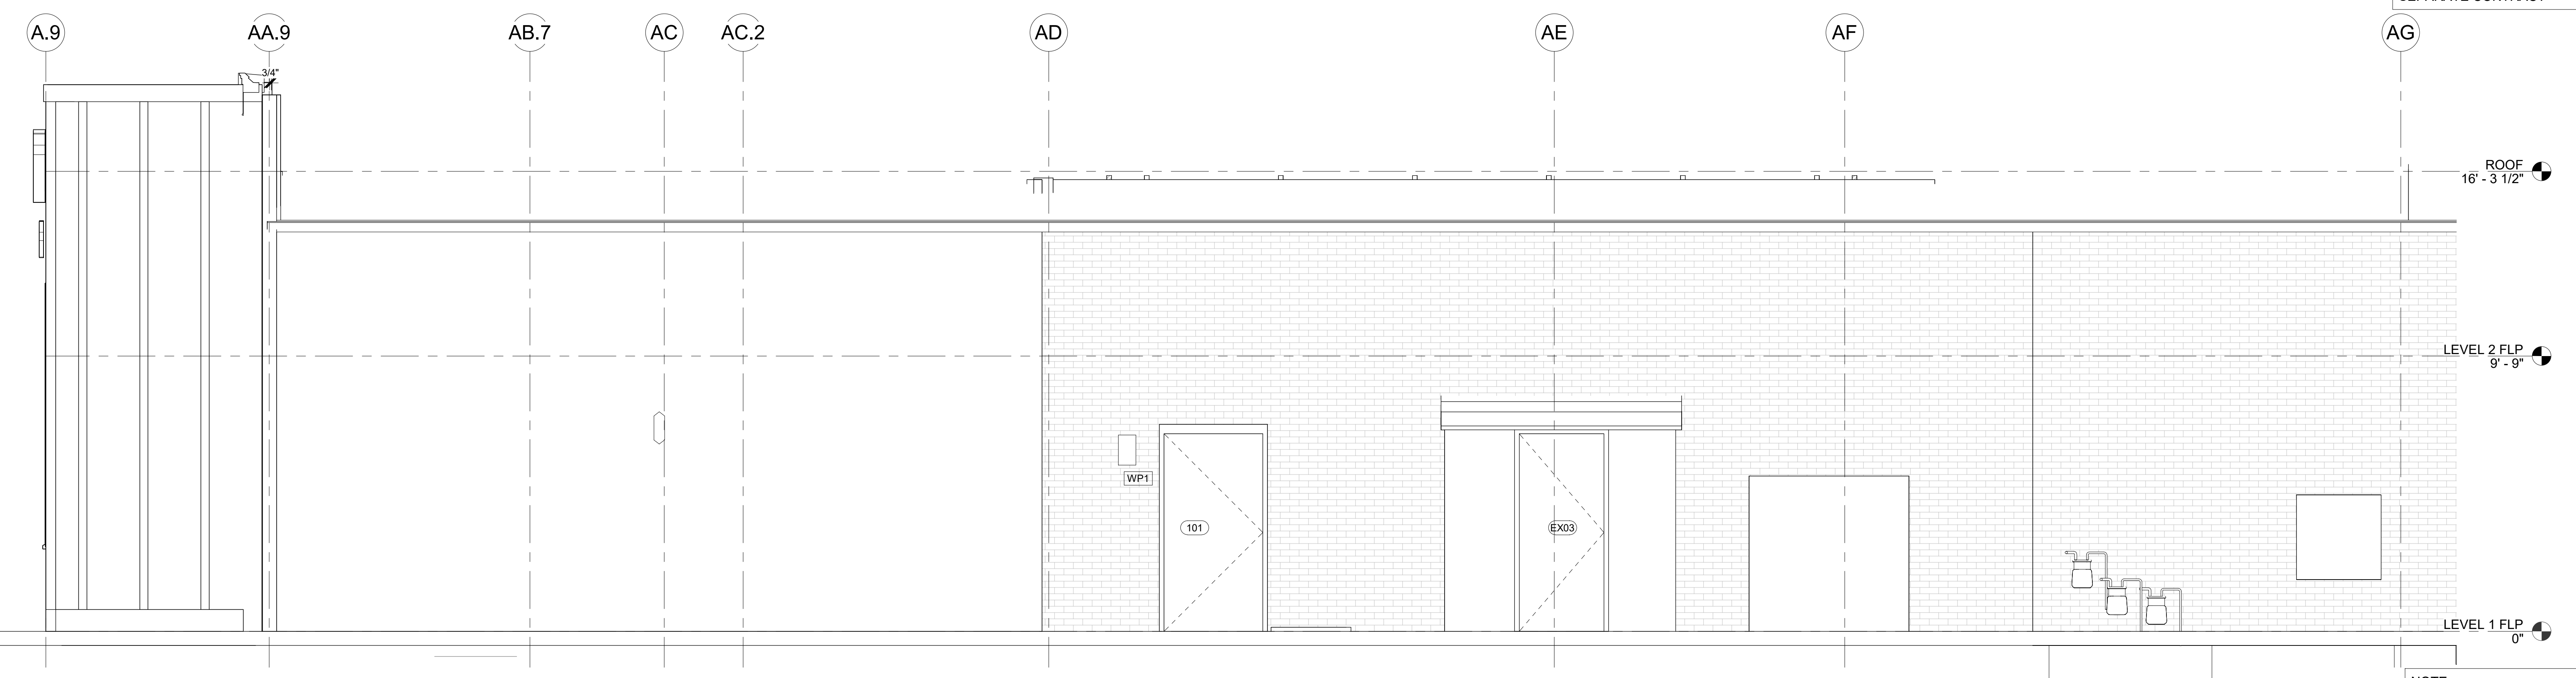

3 Elevation 14 - a
3/8" = 1'-0"

NOTE:
EXTERIOR WORK UNDER
SEPARATE CONTRACT

BURTONS GRILL AND BAR
JOHN HAGGAI
(410) 340-0503
J.HAGGAI@BURTONSGRILL.COM

OWNERS REP
DAVID CHRISS
(813) 340-3038
DAVIDLCHRISSE@GMAIL.COM

ARCHITECT
BILL WHITLOCK
WHITLOCK DESIGN GROUP, INC
760 MAIN STREET, SUITE 2-4
WALTHAM, MA 02451
O (781) 647-8008
M (781) 608-0920
BWHITLOCK@WHITLOCKDESIGNS.COM

STRUCTURAL ENGINEERING
KARTIK SAMPATH
SHEAR ENGINEERING
O (678) 664-8051
KSAMPATH@SHEARSTRUCTURAL.COM

**MECHANICAL / PLUMBING AND
FIRE PROTECTION ENGINEER**
GREGOR GRAMLICH
GRAMLICH ENGINEERING
O (727) 536-0454
GREGOR@GRAMLICH-ENGR.COM

ELECTRICAL
HAROLD HART ENGINEERING
CRAIG KALHOEFER
O (813) 287-2719
CRAIG@HHART.COM

KITCHEN DESIGNER
SINGER ASHLAND
MATT SWETZER
O (443) 833-3826
MSWETZER@SINGEREQUIPMENT.COM

ISSUED

01/30/24	
REV02/20/24	

REVISIONS

DATE	#	DESCRIPTION
02/20/24	1	BLDG COMM

PROJECT NAME
**BURTONS GRILL
& BAR**

PROJECT ADDRESS
3330 PIEDMONT RD
NE
ATLANTA, GA 30305
SPACES 27 & 28

SEAL


DRAWING TITLE
**EXTERIOR
ELEVATION**

SCALE
3/8" = 1'-0"


SHEET NUMBER

A6.0


RELEASED FOR CONSTRUCTION

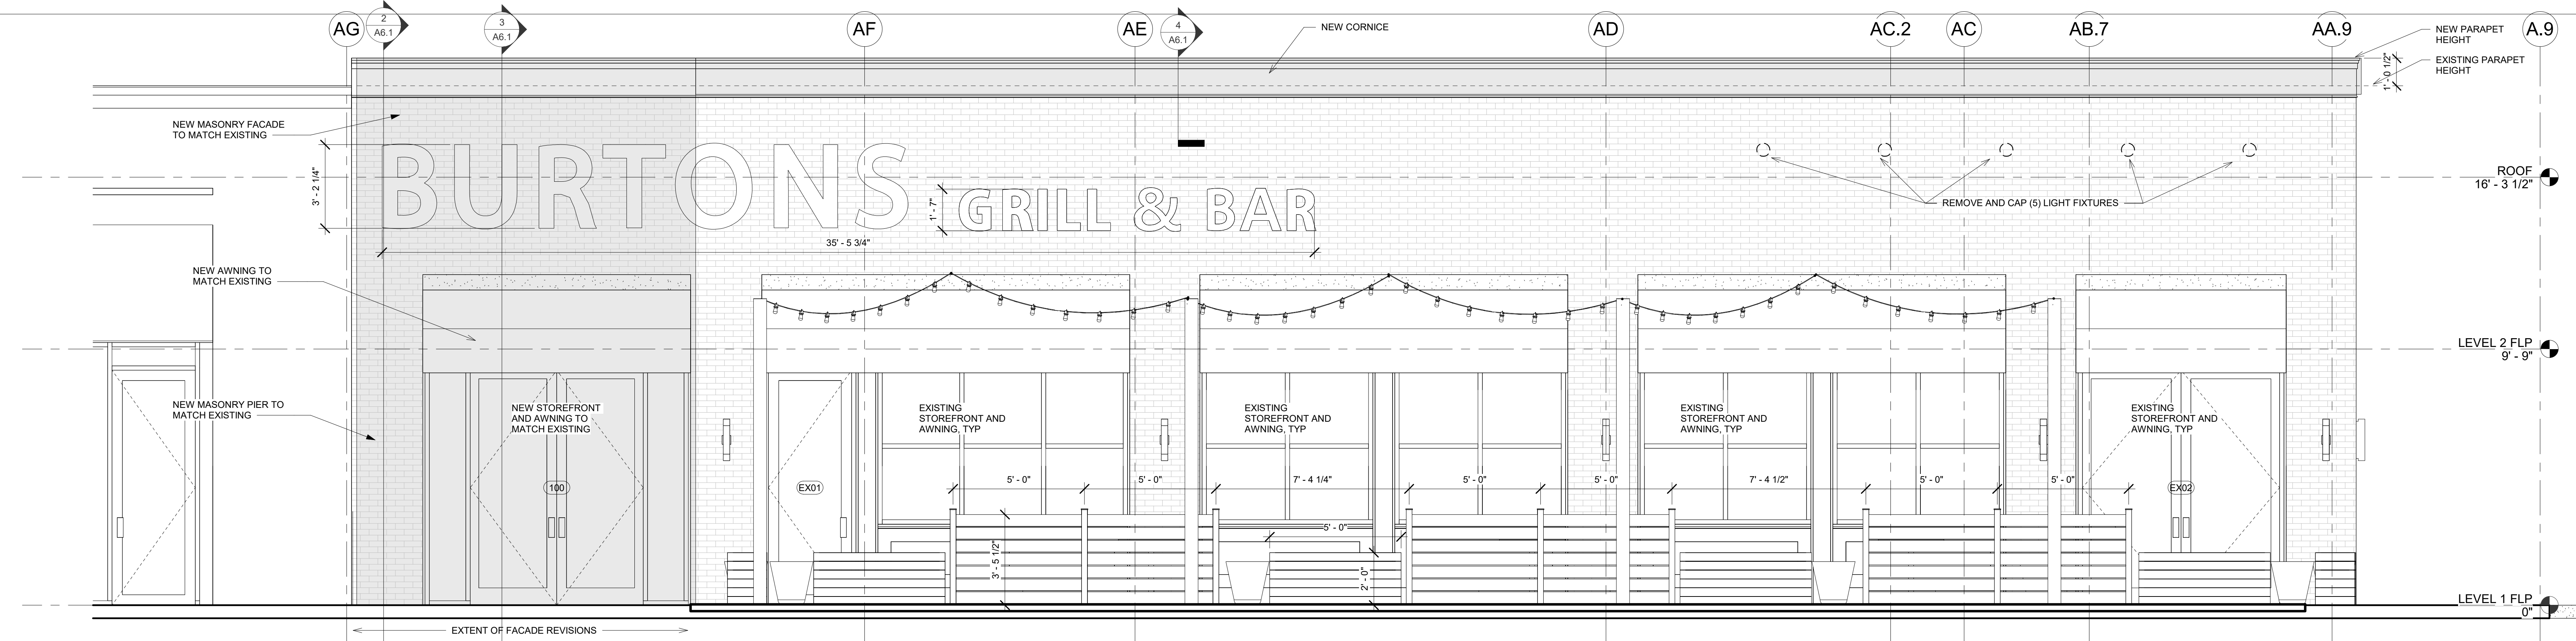

1 EXTERIOR FRONT ELEVATION
3/8" = 1'-0"

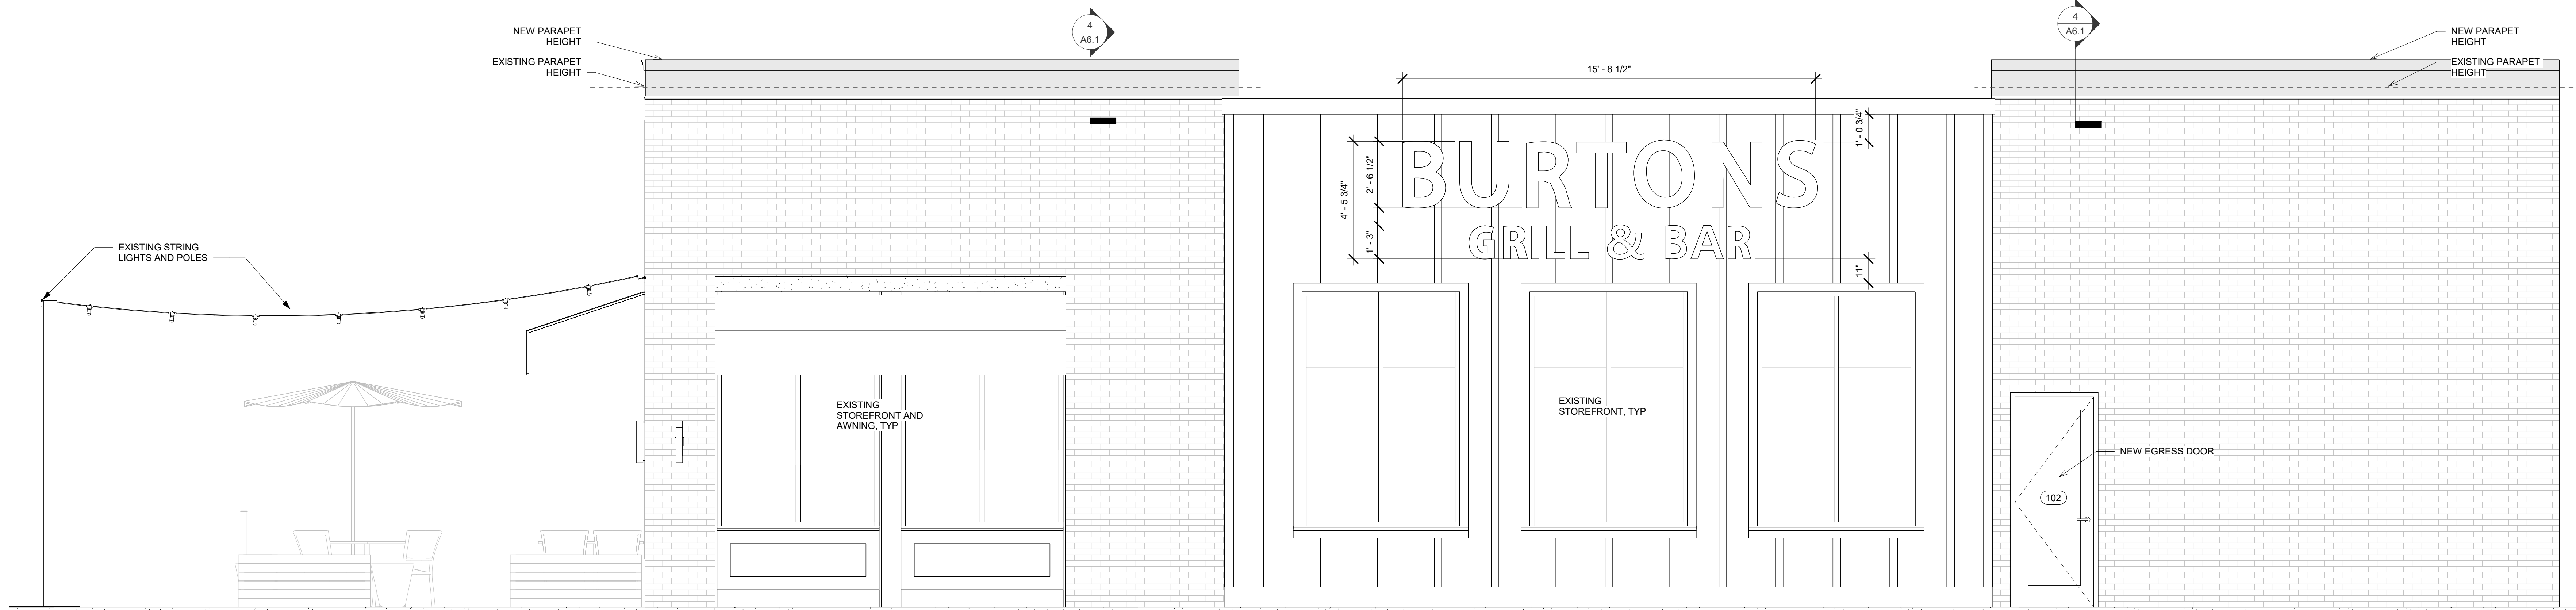

2 EXTERIOR SIDE ELEVATION
3/8" = 1'-0"

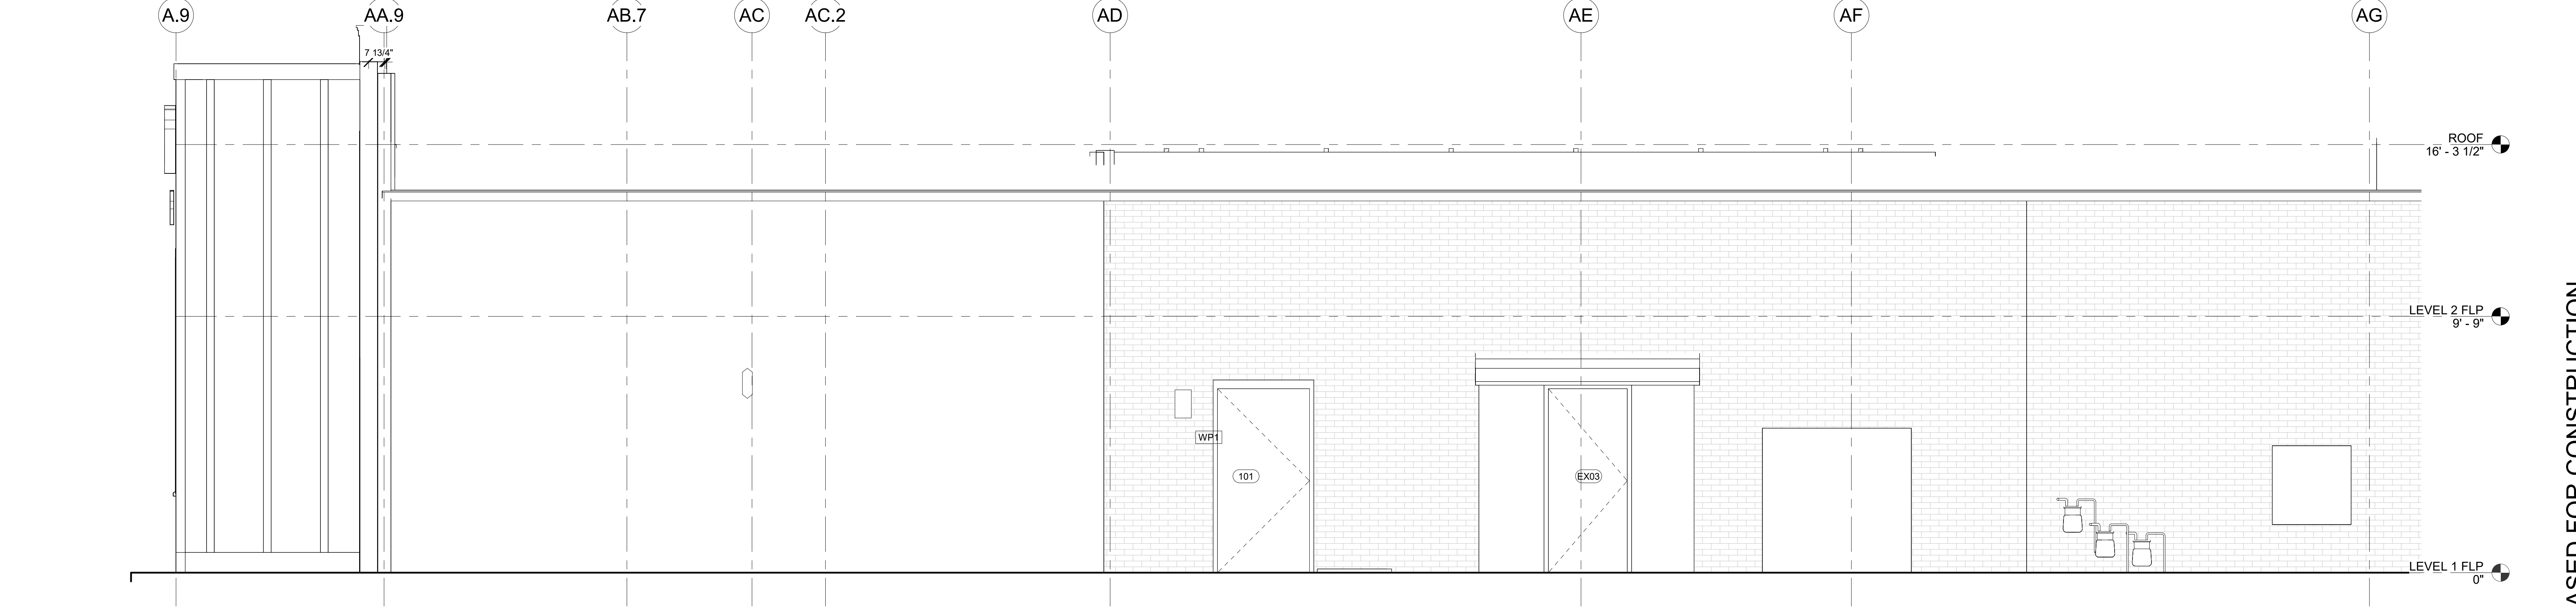

3 EXTERIOR REAR ELEVATION
3/8" = 1'-0"



BURTONS GRILL AND BAR
JOHN HAGGAI
(410) 340-0503
J.HAGGAI@BURTONSGRILL.COM

OWNERS REP
DAVID CHRISS
(813) 340-3038
DAVIDCHRISS@GMAIL.COM

ARCHITECT
BILL WHITLOCK
WHITLOCK DESIGN GROUP, INC
760 MAIN STREET, SUITE 2-4
WALTHAM, MA 02451
O (781) 647-8008
M (781) 608-0920
BWHITLOCK@WHITLOCKDESIGNS.COM

STRUCTURAL ENGINEERING
KARTIK SAMPATH
SHEAR ENGINEERING
O (678) 664-8051
KSAMPATH@SHEARSTRUCTURAL.COM

MECHANICAL / PLUMBING AND FIRE PROTECTION ENGINEER
GREGOR GRAMLICH
GRAMLICH ENGINEERING
O (727) 536-0454
GREGOR@GRAMLICH-ENGR.COM

ELECTRICAL
HAROLD HART ENGINEERING
CRAIG KALHOEFER
O (813) 287-2719
CRAIG@HHART.COM

KITCHEN DESIGNER
SINGER ASHLAND
MATT SWETZER
O (404) 833-3826
MSWETZER@SINGEREQUIPMENT.COM

ISSUED

02/10/24

REVISIONS		
Date	Number	Description

PROJECT NAME
BURTONS GRILL & BAR

PROJECT ADDRESS
3330 PIEDMONT RD NE
ATLANTA, GA 30305
SPACES 27 & 28




DRAWING TITLE
EXTERIOR ELEVATION MODIFICATIONS

SCALE
3/8" = 1'-0"


SHEET NUMBER

A6.2


RELEASED FOR CONSTRUCTION

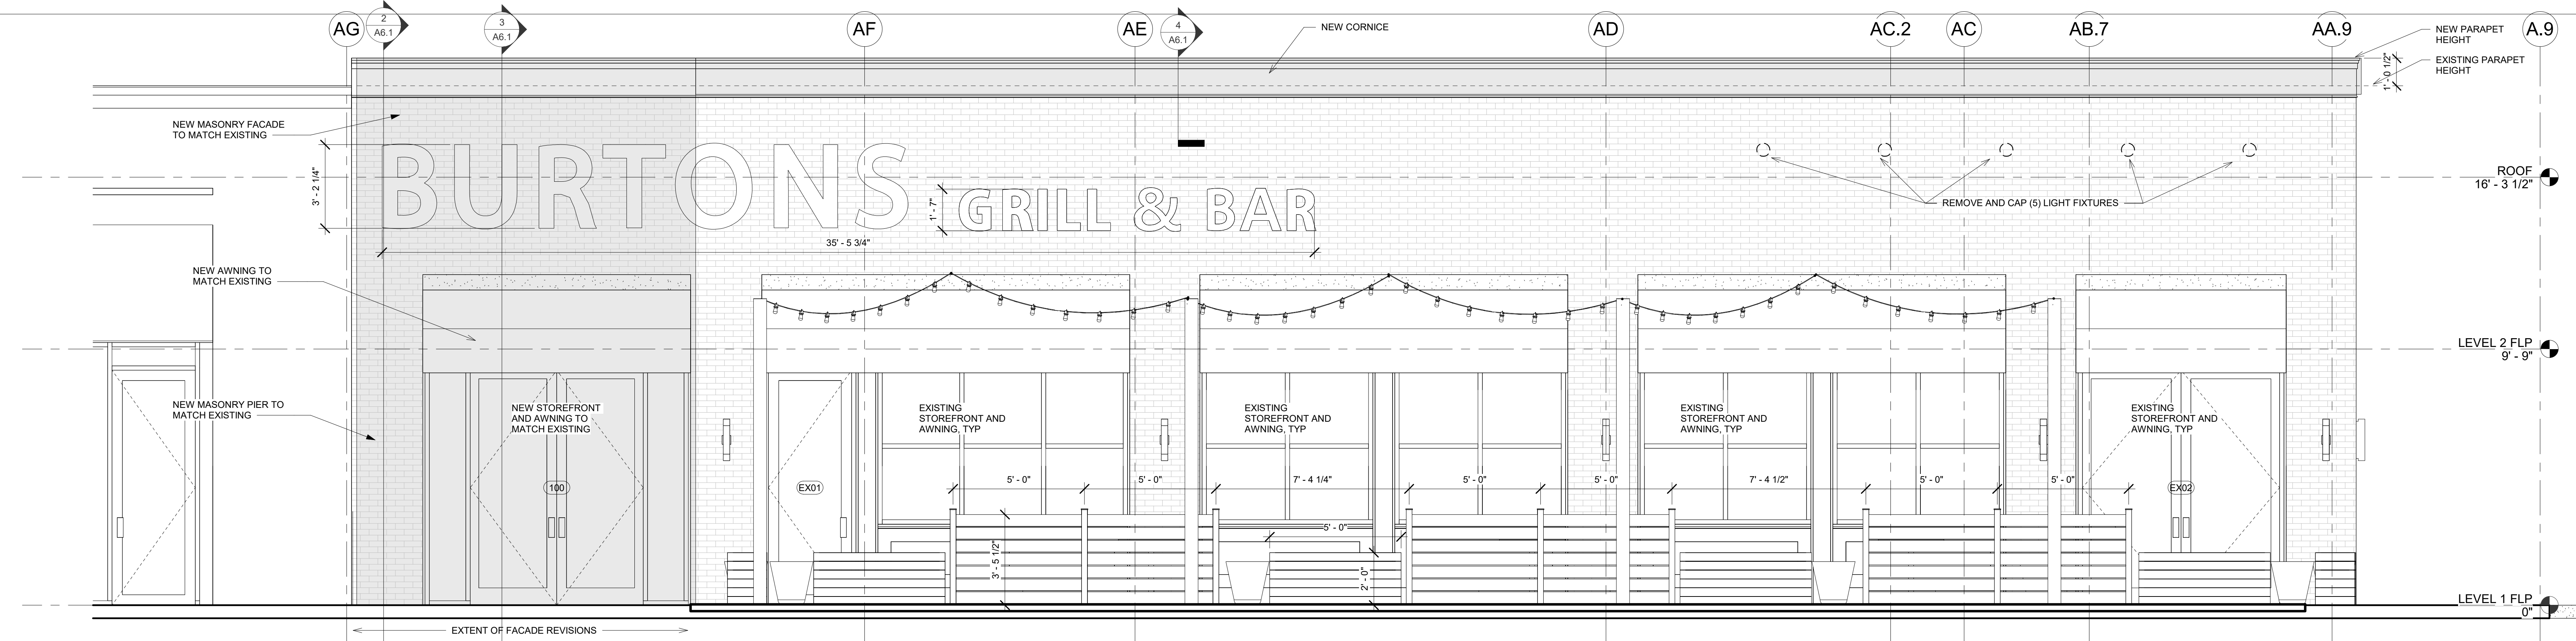

1 EXTERIOR FRONT ELEVATION
3/8" = 1'-0"

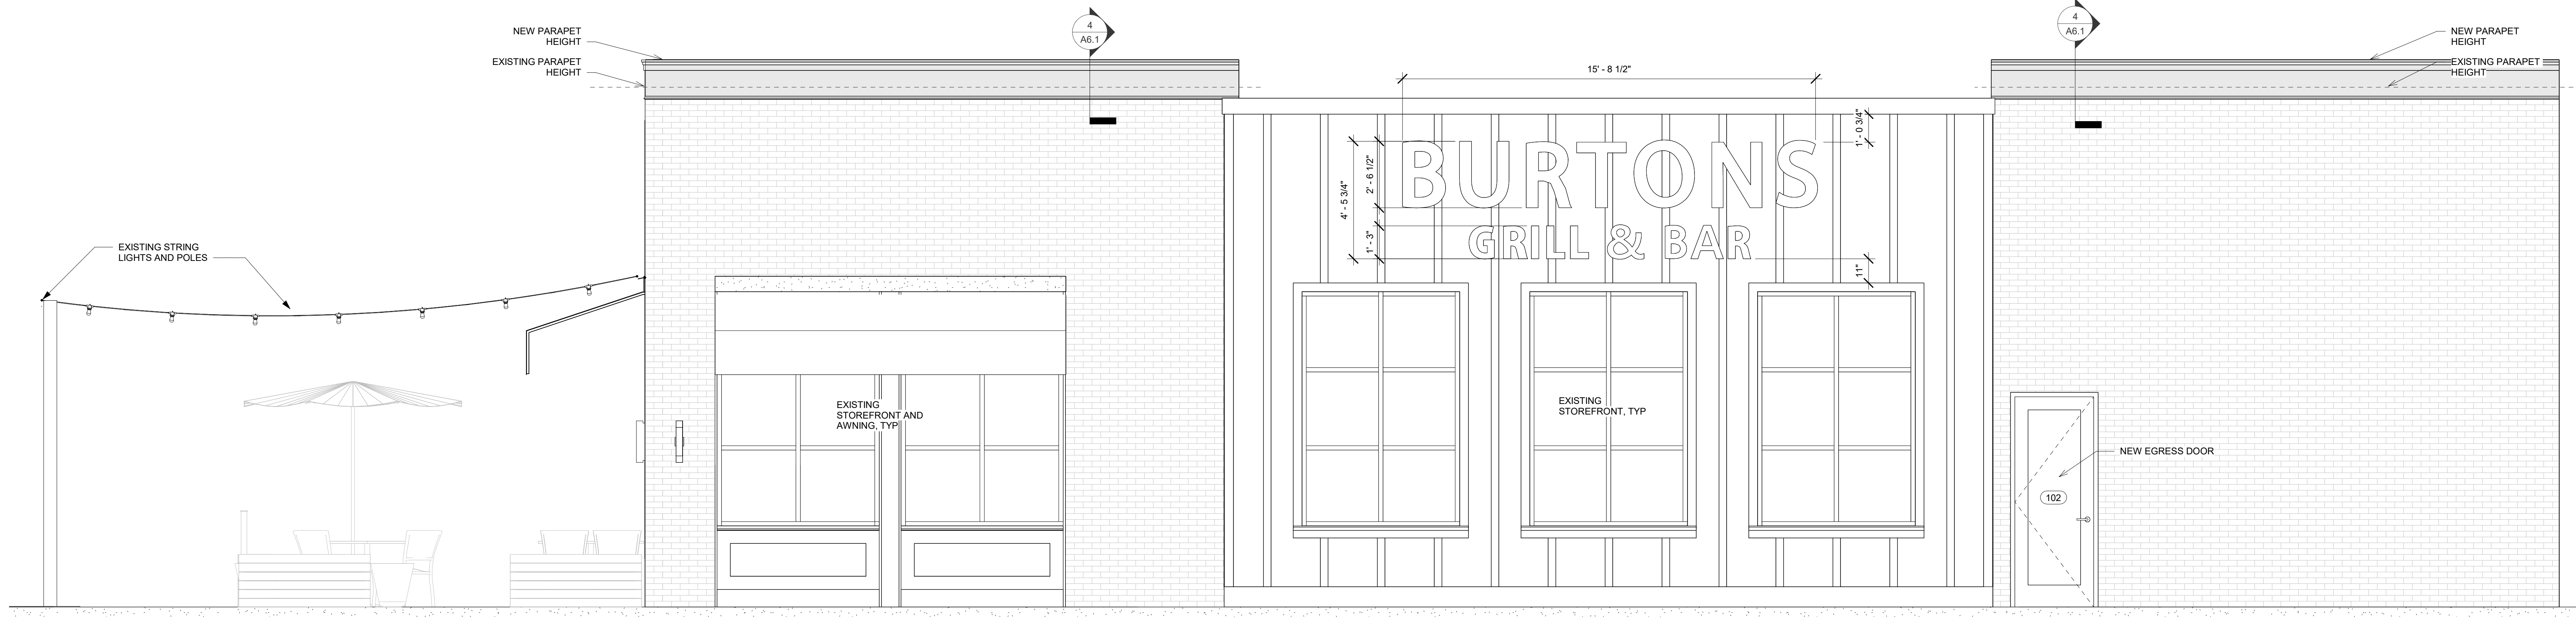

2 EXTERIOR SIDE ELEVATION
3/8" = 1'-0"

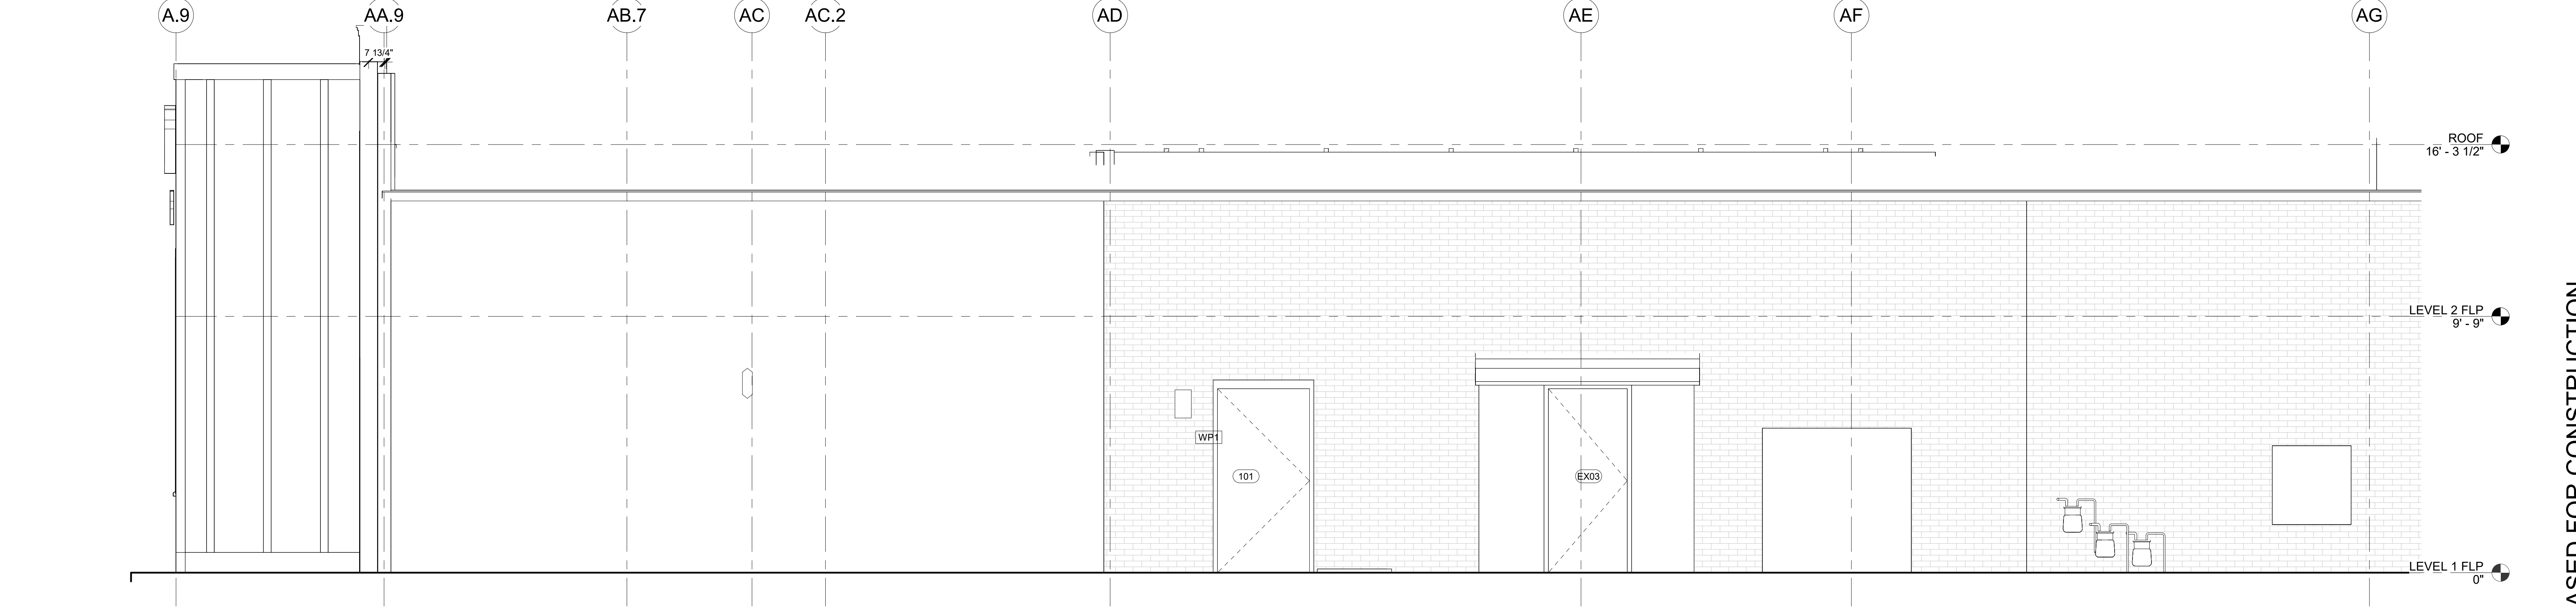

3 EXTERIOR REAR ELEVATION
3/8" = 1'-0"

BURTONS GRILL AND BAR
JOHN HAGGAI
(410) 340-0503
J.HAGGAI@BURTONSGRILL.COM

OWNERS REP
DAVID CHRISS
(813) 340-3038
DAVIDCHRISS@GMAIL.COM

ARCHITECT
BILL WHITLOCK
WHITLOCK DESIGN GROUP, INC
760 MAIN STREET, SUITE 2-4
WALTHAM, MA 02451
O (781) 647-8008
M (781) 608-0920
BWHITLOCK@WHITLOCKDESIGNS.COM

STRUCTURAL ENGINEERING
KARTIK SAMPATH
SHEAR ENGINEERING
O (678) 664-8051
KSAMPATH@SHEARSTRUCTURAL.COM

MECHANICAL / PLUMBING AND FIRE PROTECTION ENGINEER
GREGOR GRAMLICH
GRAMLICH ENGINEERING
O (727) 536-0454
GREGOR@GRAMLICH-ENGR.COM

ELECTRICAL
HAROLD HART ENGINEERING
CRAIG KALHOEFER
O (813) 287-2719
CRAIG@HHART.COM

KITCHEN DESIGNER
SINGER ASHLAND
MATT SWETZER
O (443) 833-3826
MSWETZER@SINGEREQUIPMENT.COM

ISSUED

02/10/24

REVISIONS		
Date	Number	Description

PROJECT NAME
BURTONS GRILL & BAR

PROJECT ADDRESS
3330 PIEDMONT RD NE
ATLANTA, GA 30305
SPACES 27 & 28



DRAWING TITLE
EXTERIOR ELEVATION MODIFICATIONS


SCALE
3/8" = 1'-0"

SHEET NUMBER


A6.2

RELEASED FOR CONSTRUCTION


F:\Documents\Burtons Grill\CF_11282023_Burton-5003.v1
 EXTERIOR ELEVATION & SECTION A6.3
 Printed: 2/10/2024 2:31:57 PM

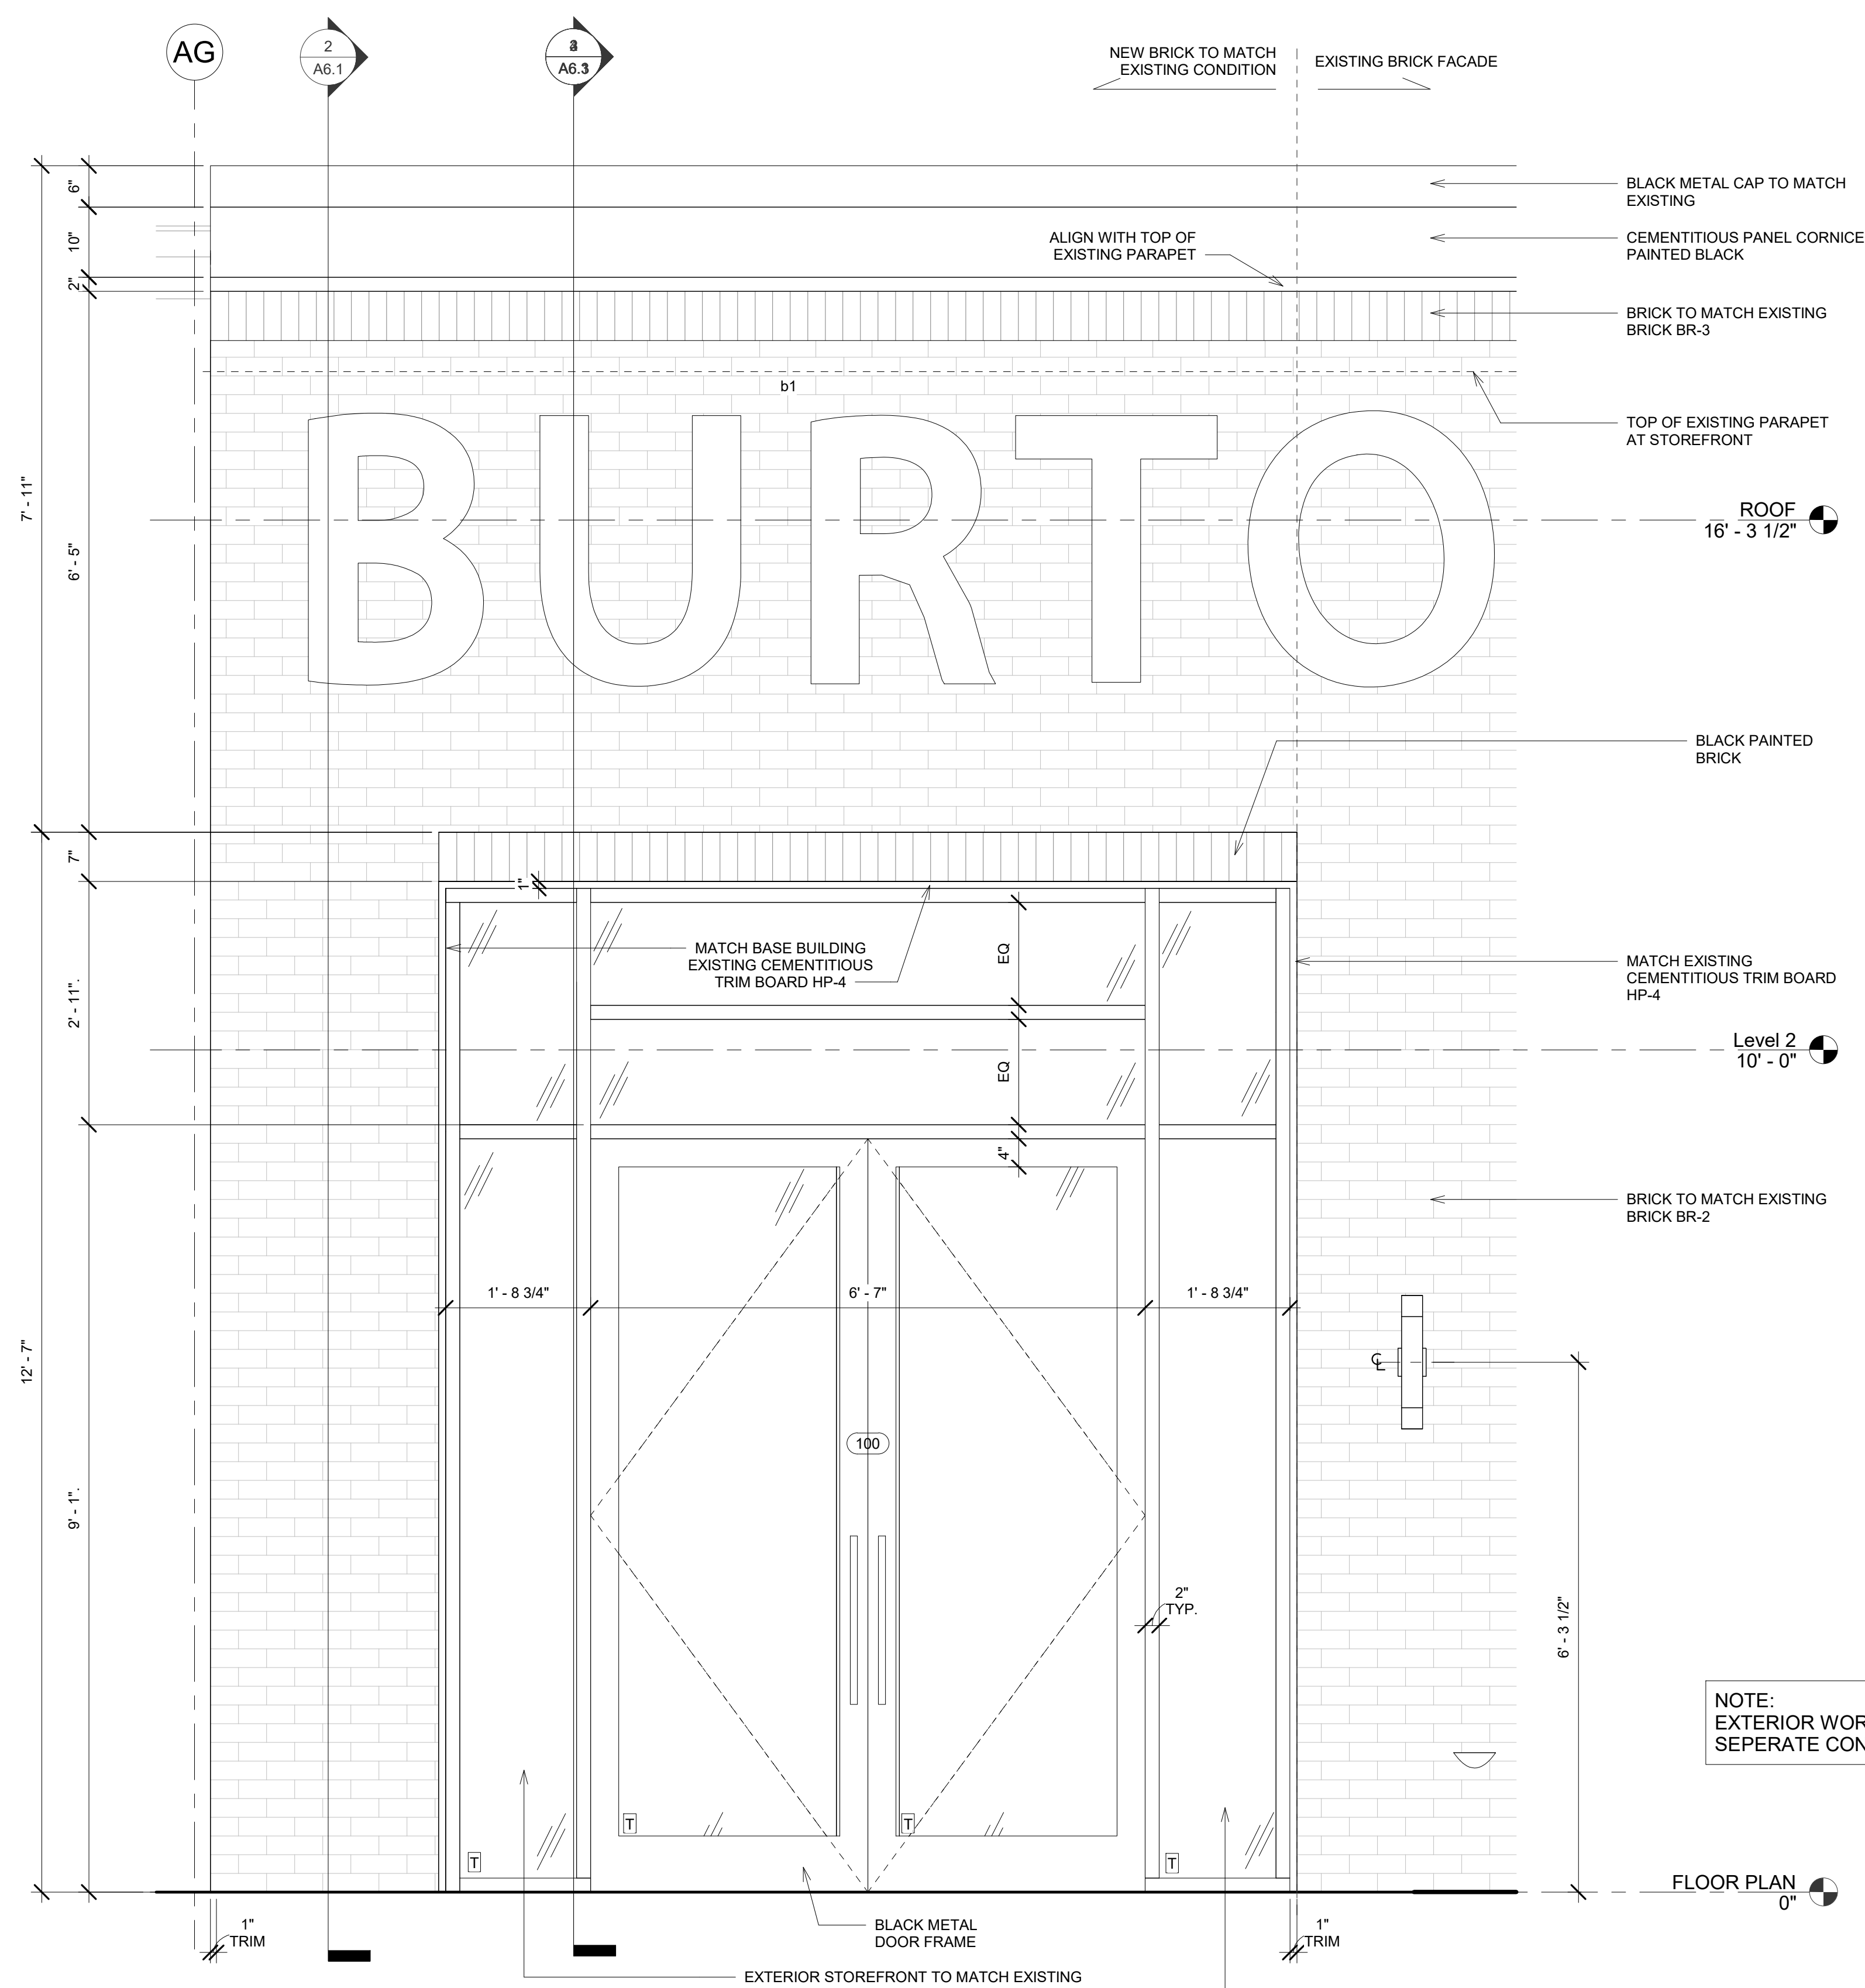

1 ELEVATION - STOREFRONT Copy 1
 3/4" = 1'-0"

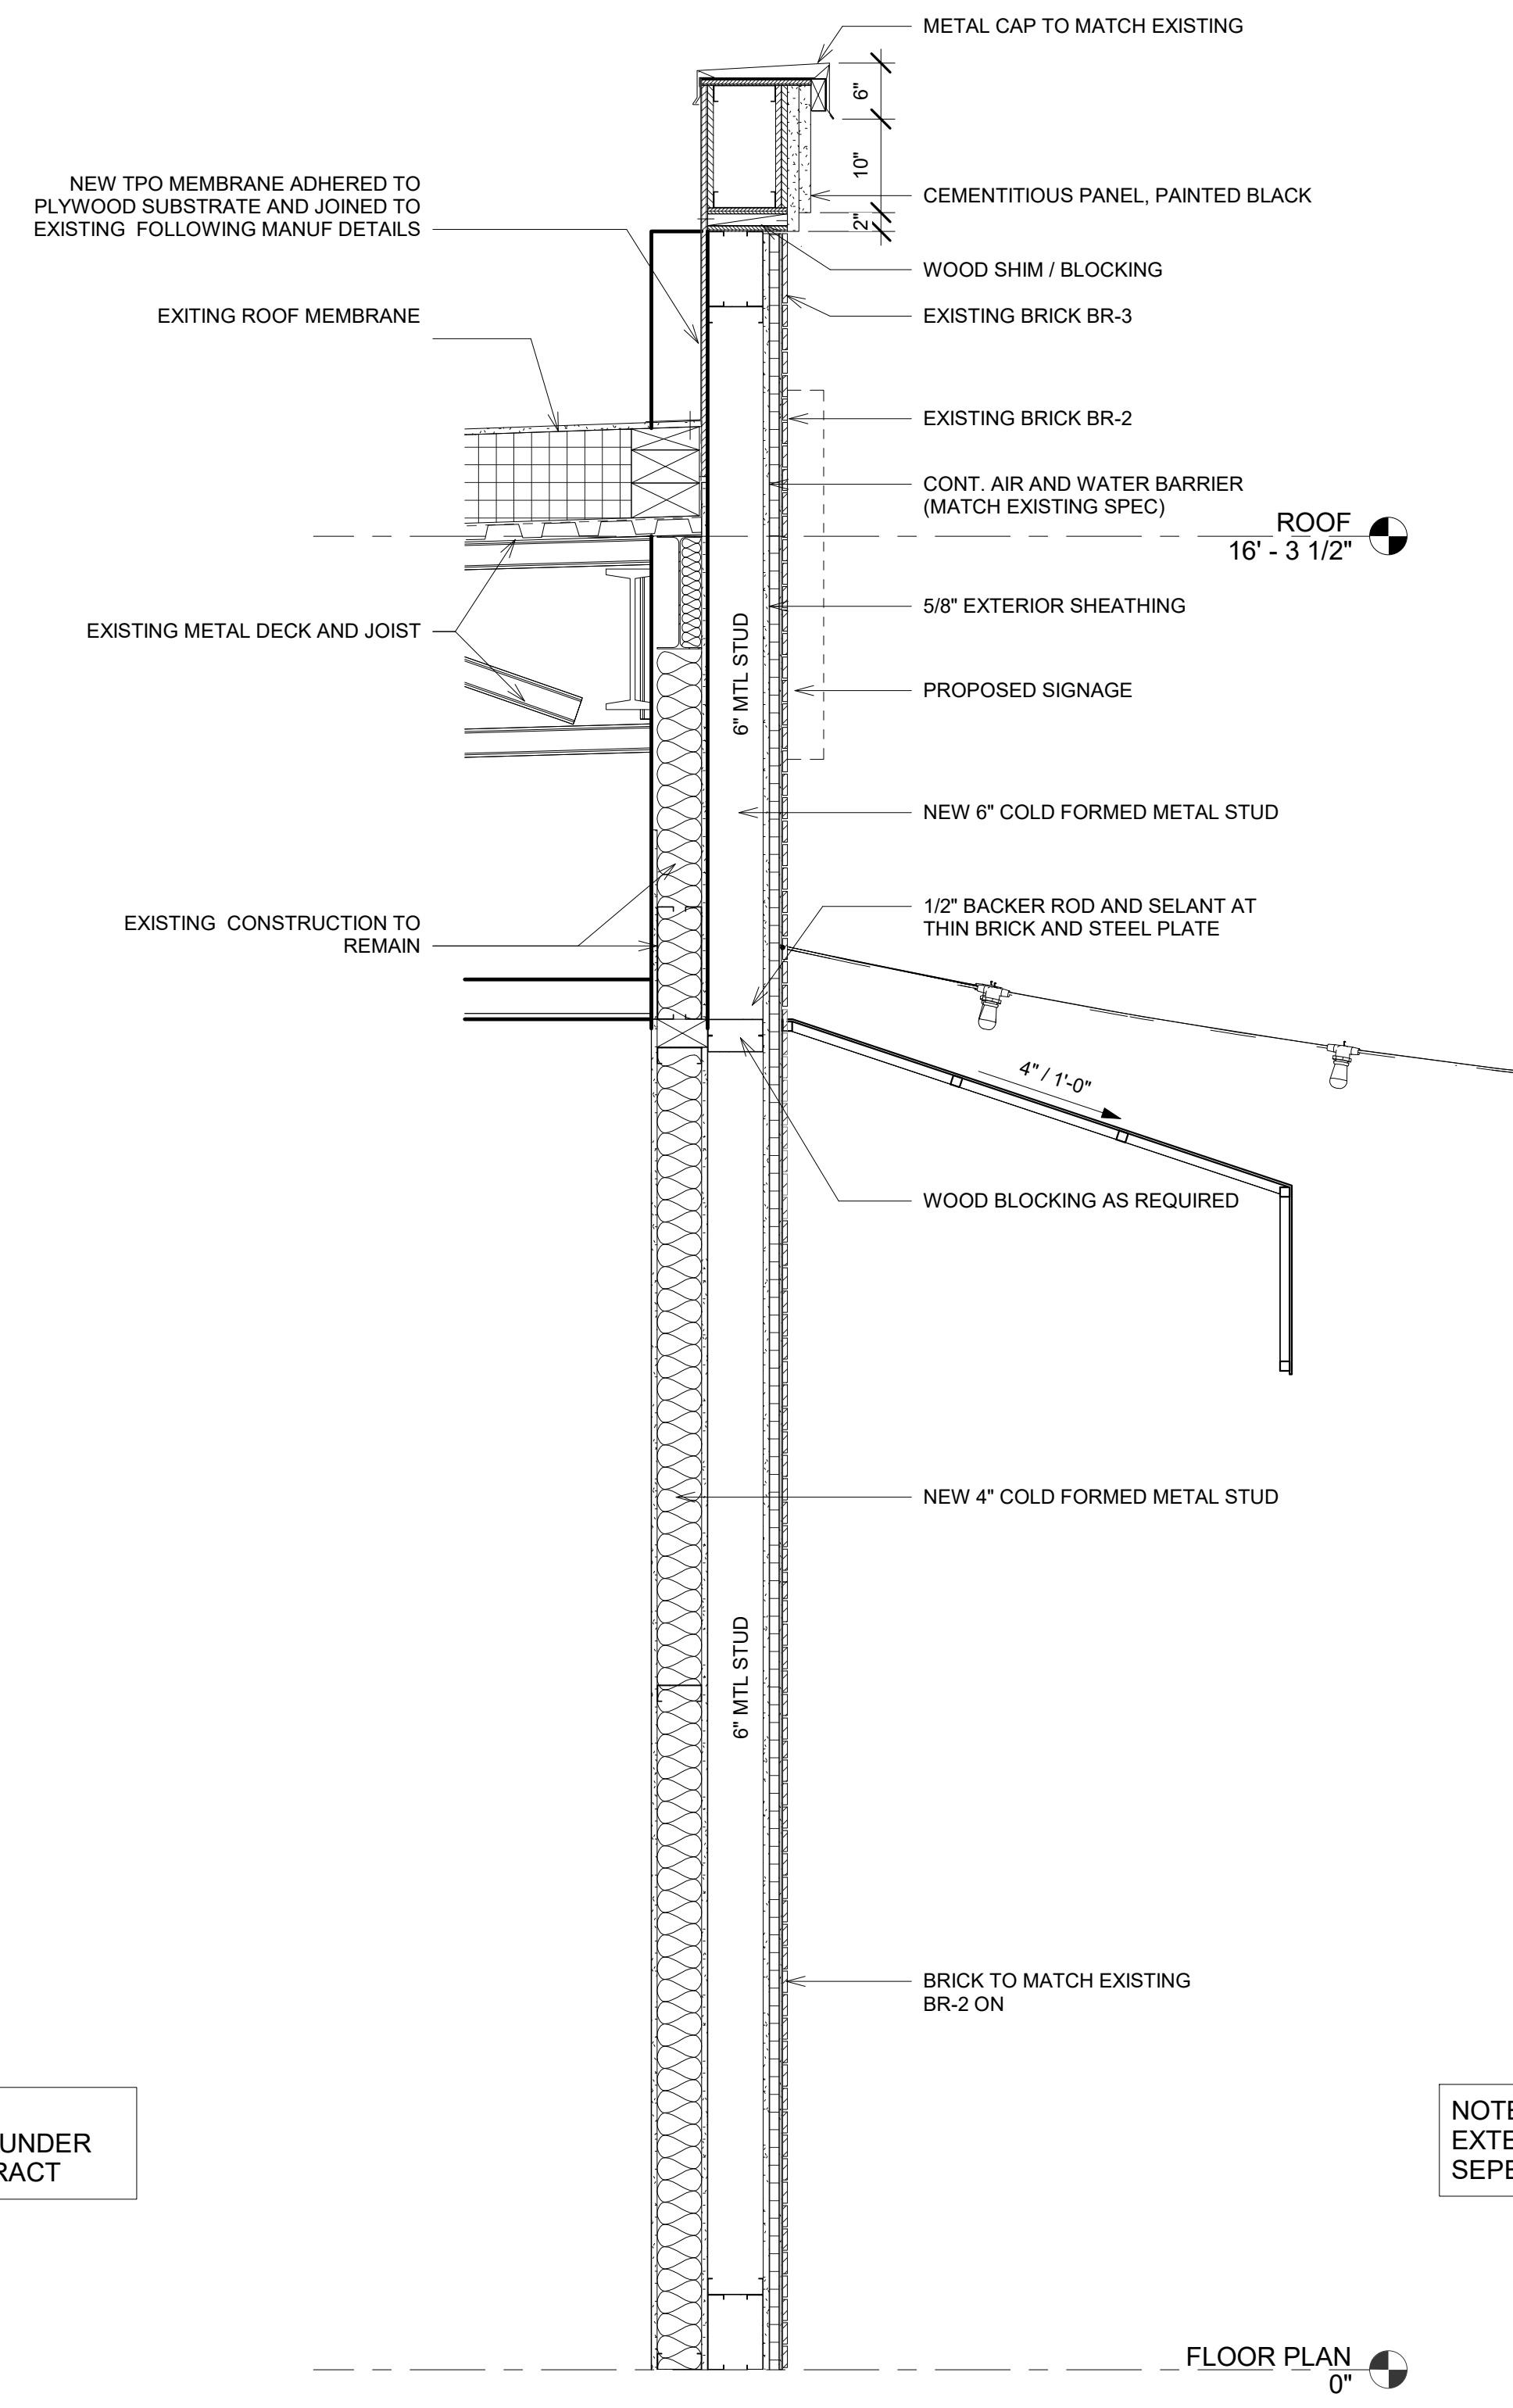

2 WALL SECTION - STOREFRONT B Copy 1
 3/4" = 1'-0"

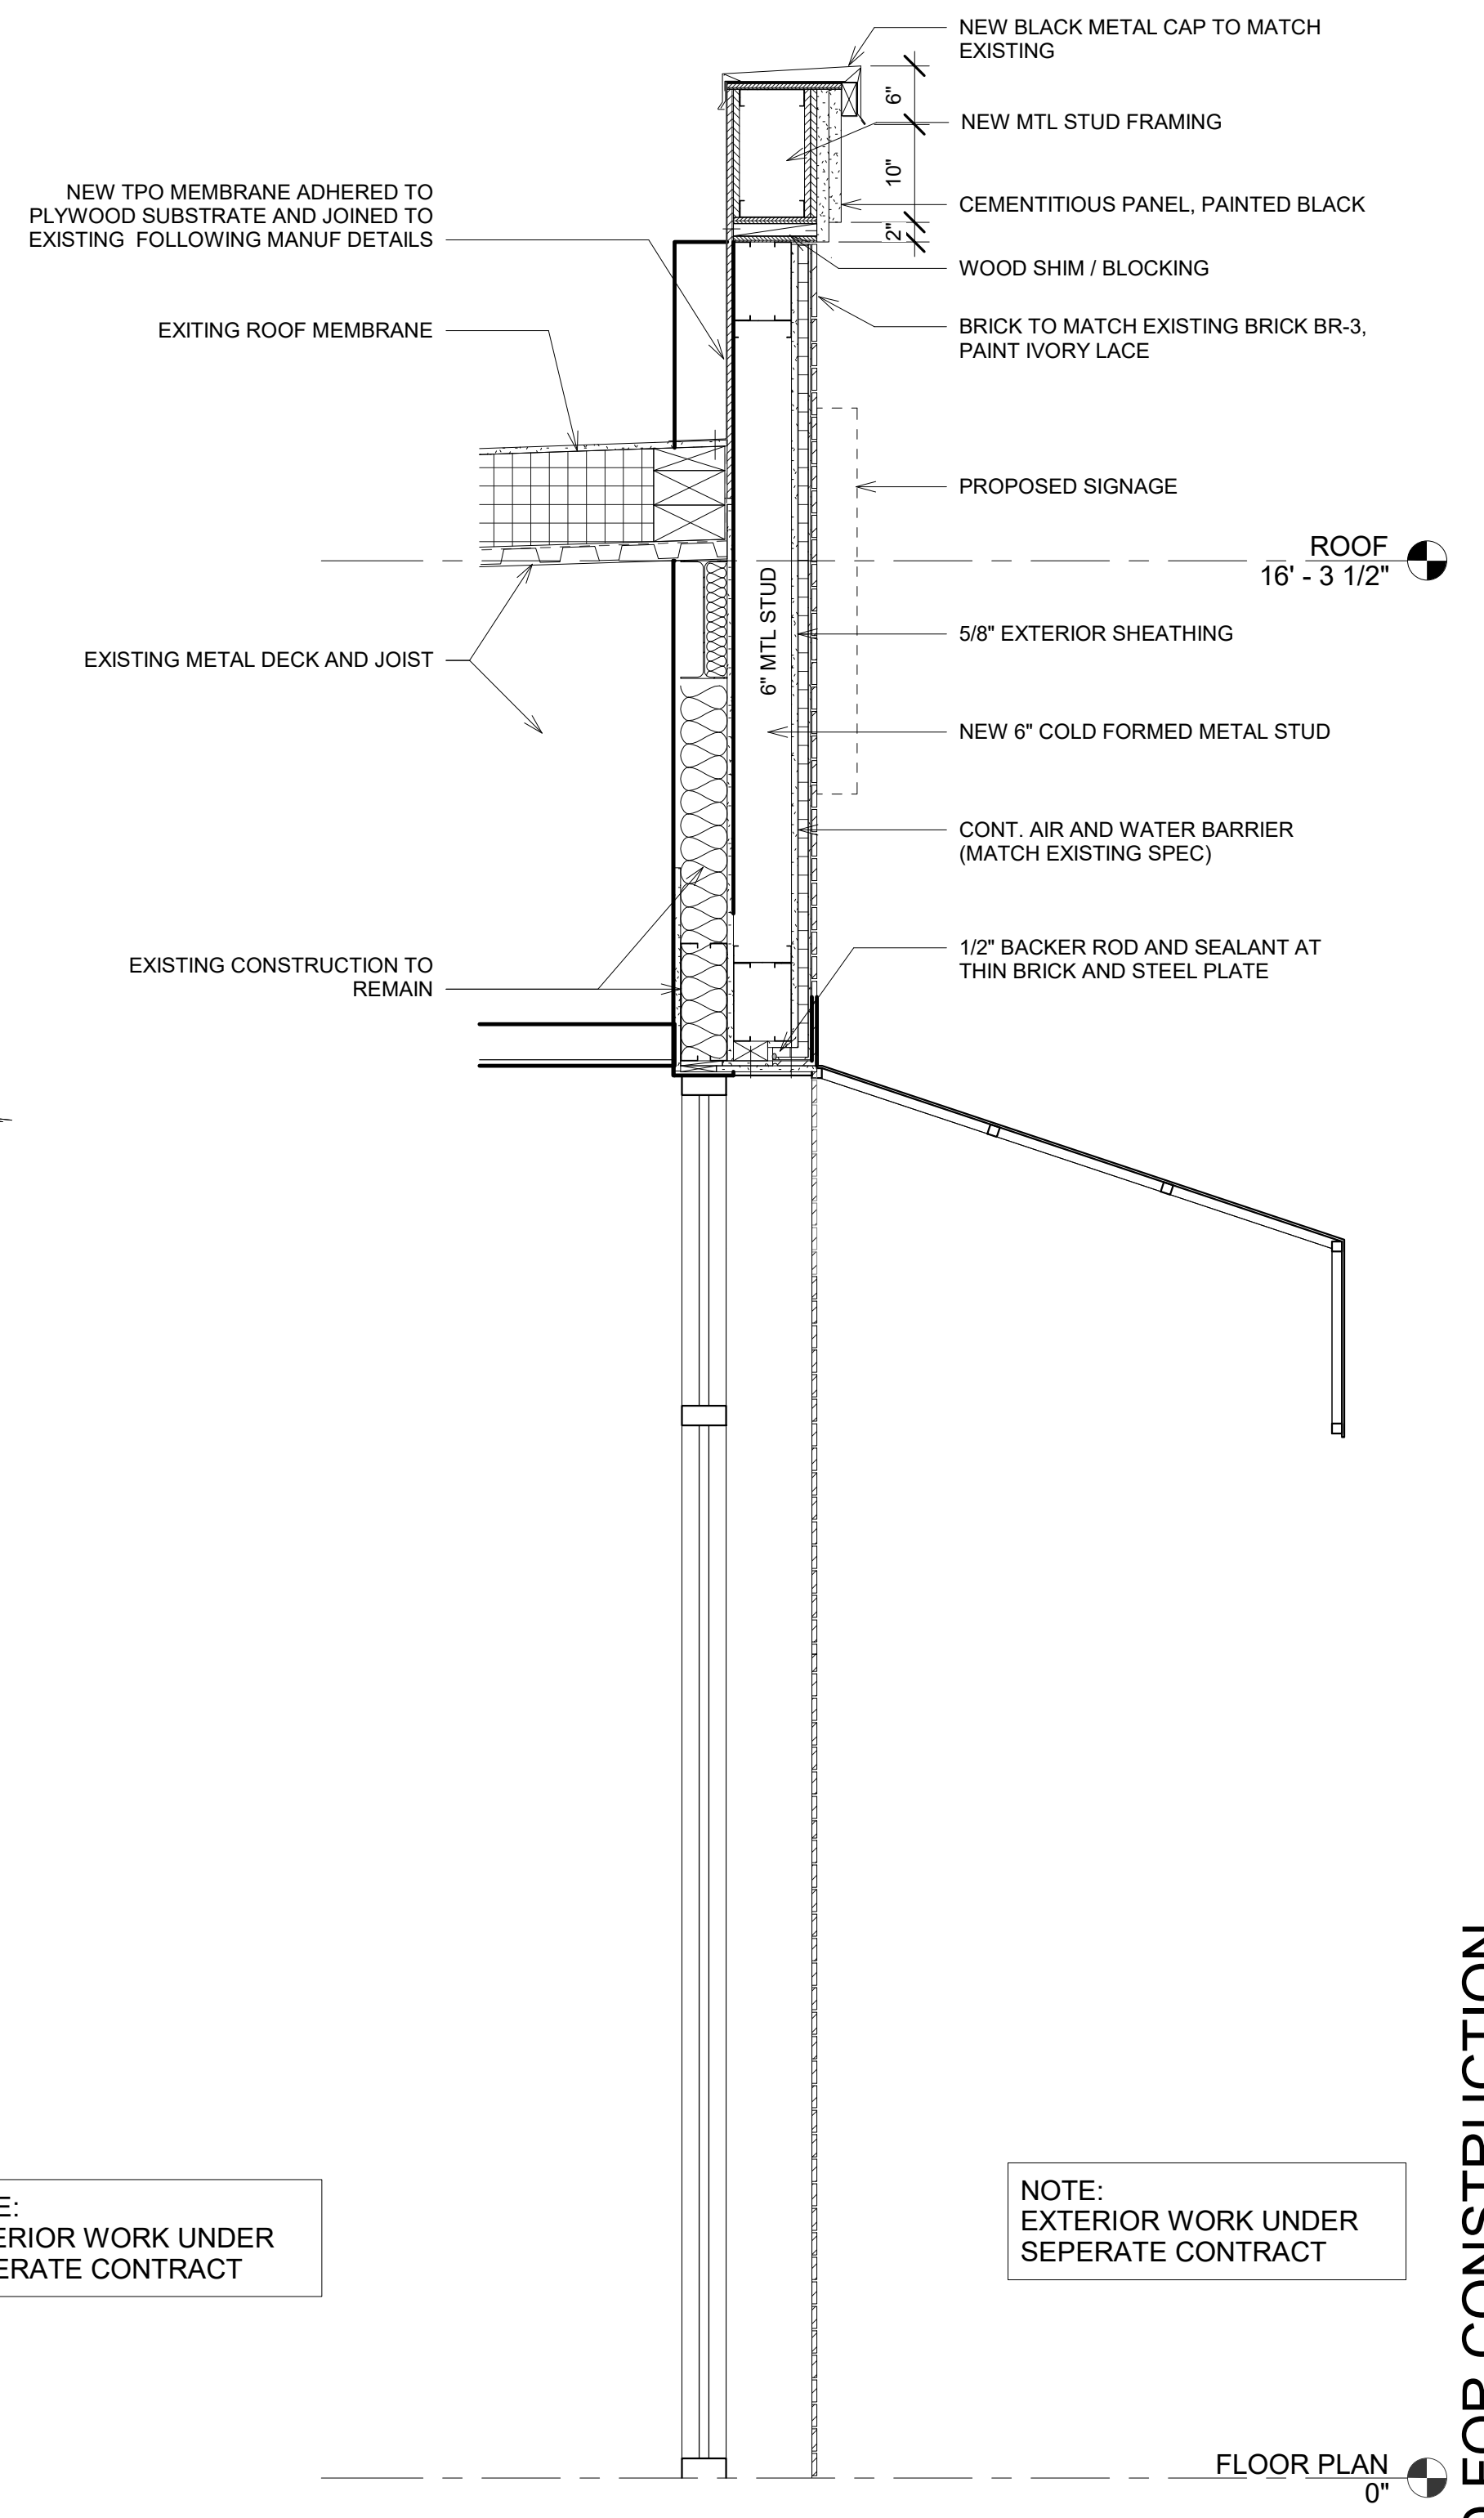


3 WALL SECTION - STORE FRONT A Copy 1
 3/4" = 1'-0"

NOTE:
 EXTERIOR WORK UNDER
 SEPERATE CONTRACT

NOTE:
 EXTERIOR WORK UNDER
 SEPERATE CONTRACT

NOTE:
 EXTERIOR WORK UNDER
 SEPERATE CONTRACT

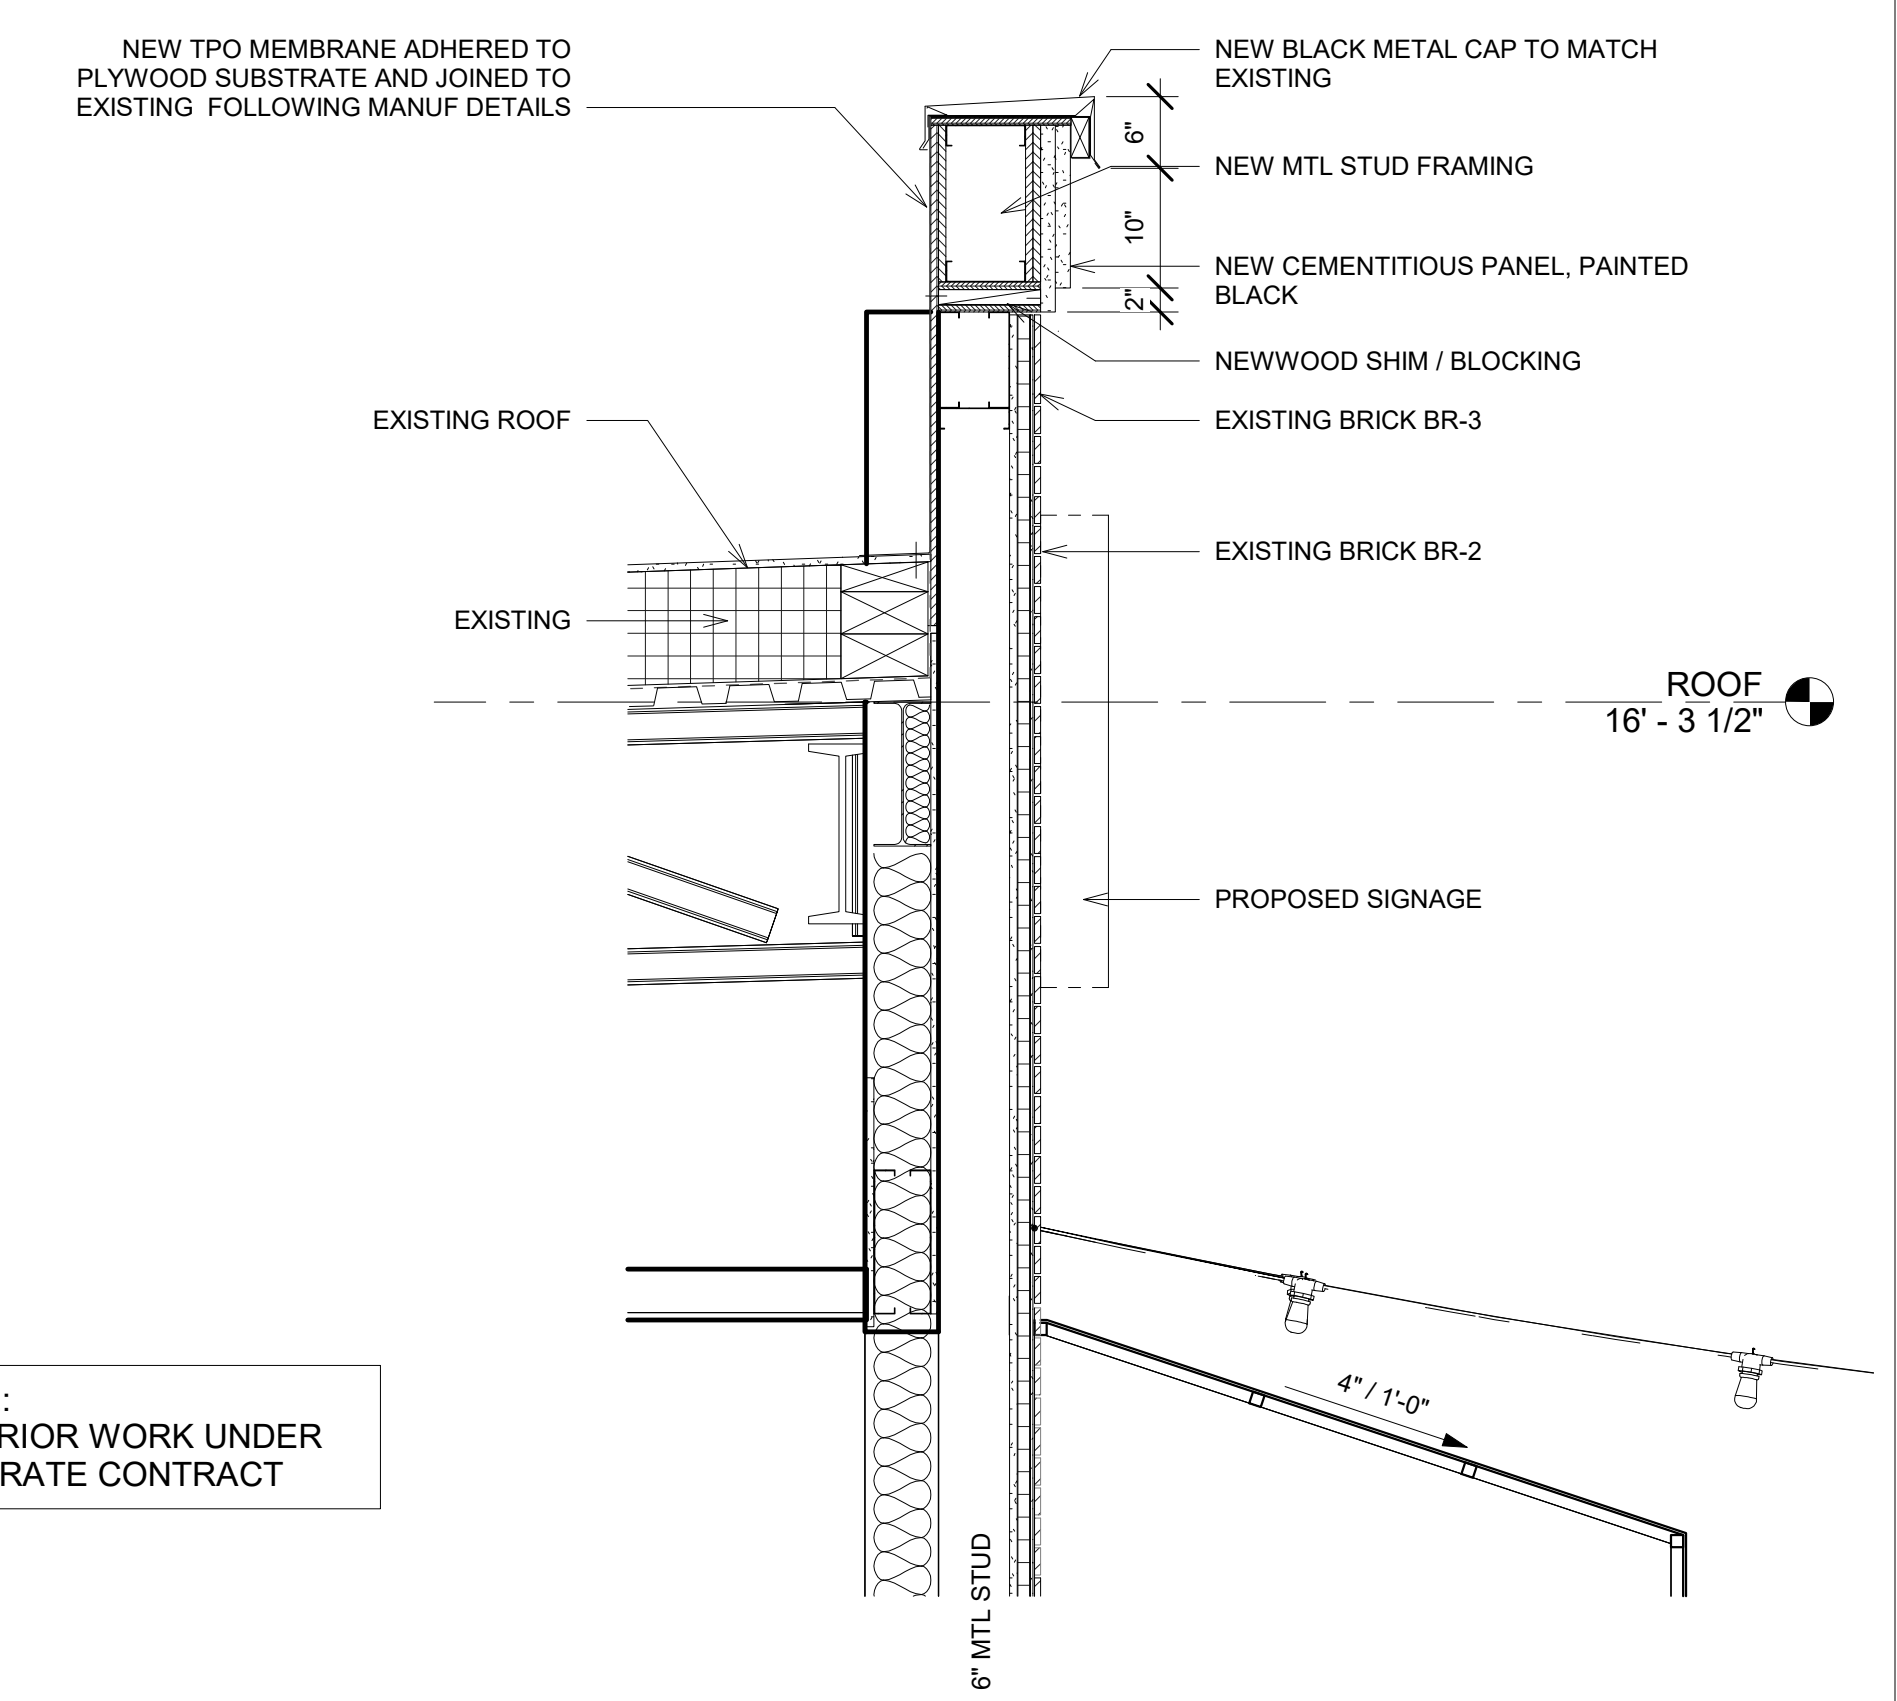

4 WALL SECTION - TYPICAL Copy 1
 3/4" = 1'-0"

RELEASED FOR CONSTRUCTION



760 Main Street, Suite 2-4, Waltham, MA 02451 781.647.8008
 www.whitlockdesigns.com

BURTONS GRILL AND BAR
 JOHN HAGGAI
 (410) 340-0503
 J.HAGGAI@BURTONSGRILL.COM

OWNERS REP
 DAVID CHRISS
 (813) 340-3038
 DAVIDLCHRISSE@GMAIL.COM

ARCHITECT
 BILL WHITLOCK
 WHITLOCK DESIGN GROUP, INC
 760 MAIN STREET, SUITE 2-4
 WALTHAM, MA 02451
 O (781) 647-8008
 M (781) 608-0920
 BWHITLOCK@WHITLOCKDESIGNS.COM

STRUCTURAL ENGINEERING
 KARTIK SAMPATH
 SHEAR ENGINEERING
 O (678) 664-8051
 KSAMPATH@SHEARSTRUCTURAL.COM

**MECHANICAL / PLUMBING AND
 FIRE PROTECTION ENGINEER**
 GREGOR GRAMLICH
 GRAMLICH ENGINEERING
 O (727) 536-0454
 GREGOR@GRAMLICH-ENGR.COM

ELECTRICAL
 HAROLD HART ENGINEERING
 CRAIG KALHOEFER
 O (813) 287-2719
 CRAIG@HHART.COM

KITCHEN DESIGNER
 SINGER ASHLAND
 MATT SWITZTER
 O (443) 833-3826
 MSWITZTER@SINGEREQUIPMENT.COM

ISSUED
 02/10/24

REVISIONS		
Date	Number	Description

PROJECT NAME
**BURTONS GRILL
 & BAR**
 PROJECT ADDRESS
 3330 PIEDMONT RD
 NE
 ATLANTA, GA 30305
 SPACES 27 & 28



DRAWING TITLE
**EXTERIOR
 ELEVATION &
 SECTION**

SCALE
 3/4" = 1'-0"

SHEET NUMBER

A6.3